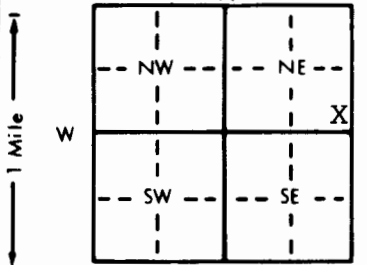


1 LOCATION OF WATER WELL: Fraction SE 1/4 SE 1/4 NE 1/4 Section Number 4 Township Number T 18 S Range Number R 17 E/W
 County: OSAGE

Distance and direction from nearest town or city street address of well if located within city?
4 1/4 South of Quenemo

2 WATER WELL OWNER: Frank Dickey
 RR#, St. Address, Box #: Rt. 1 Box 145 Board of Agriculture, Division of Water Resources
 City, State, ZIP Code: Quenemo, KS 66528 Application Number:

3 LOCATE WELL'S LOCATION WITH AN "X" IN SECTION BOX:  4 DEPTH OF COMPLETED WELL: 220' ft. ELEVATION:
 Depth(s) Groundwater Encountered 1. _____ ft. 2. _____ ft. 3. _____ ft.
 WELL'S STATIC WATER LEVEL: 138' ft. below land surface measured on mo/day/yr 6-27-94
 Pump test data: Well water was _____ ft. after _____ hours pumping _____ gpm
 Est. Yield: 14 gpm: Well water was _____ ft. after _____ hours pumping _____ gpm
 Bore Hole Diameter: 8 3/4 in. to _____ ft., and _____ in. to _____ ft.
 WELL WATER TO BE USED AS: 5 Public water supply 8 Air conditioning 11 Injection well
1 Domestic 3 Feedlot 6 Oil field water supply 9 Dewatering 12 Other (Specify below)
 2 Irrigation 4 Industrial 7 Lawn and garden only 10 Monitoring well
 Was a chemical/bacteriological sample submitted to Department? Yes _____ No X; If yes, mo/day/yr sample was submitted
 Water Well Disinfected? Yes X No

5 TYPE OF BLANK CASING USED: 5 Wrought iron 8 Concrete tile CASING JOINTS: Glued X Clamped _____
 1 Steel 3 RMP (SR) 6 Asbestos-Cement 9 Other (specify below) Welded _____
 2 PVC 4 ABS 7 Fiberglass Threaded _____
 Blank casing diameter: 5" in. to 0-140 ft., Dia. 5" in. to 200-220 ft., Dia. _____ in. to _____ ft.
 Casing height above land surface: 24" in., weight 2.82 lbs./ft. Wall thickness or gauge No. .258
 TYPE OF SCREEN OR PERFORATION MATERIAL: 7 PVC 10 Asbestos-cement
 1 Steel 3 Stainless steel 5 Fiberglass 8 RMP (SR) 11 Other (specify) _____
 2 Brass 4 Galvanized steel 6 Concrete tile 9 ABS 12 None used (open hole)
 SCREEN OR PERFORATION OPENINGS ARE: 5 Gauzed wrapped 8 Saw cut 11 None (open hole)
 1 Continuous slot 3 Mill slot 6 Wire wrapped 9 Drilled holes
 2 Louvered shutter 4 Key punched 7 Torch cut 10 Other (specify) _____
 SCREEN-PERFORATED INTERVALS: From 140 ft. to 200 ft., From _____ ft. to _____ ft.
 GRAVEL PACK INTERVALS: From 24 ft. to 220 ft., From _____ ft. to _____ ft.

6 GROUT MATERIAL: 1 Neat cement 2 Cement grout 3 Bentonite 4 Other _____
 Grout intervals: From 4 ft. to 24 ft., From _____ ft. to _____ ft., From _____ ft. to _____ ft.
 What is the nearest source of possible contamination: 10 Livestock pens 14 Abandoned water well
 1 Septic tank 4 Lateral lines 7 Pit privy 11 Fuel storage 15 Oil well/Gas well
 2 Sewer lines 5 Cess pool 8 Sewage lagoon 12 Fertilizer storage 16 Other (specify below)
 3 Watertight sewer lines 6 Seepage pit 9 Feedyard 13 Insecticide storage
 Direction from well? south east How many feet? 130'

FROM	TO	LITHOLOGIC LOG	FROM	TO	PLUGGING INTERVALS
0	2	Top Soil	99	102	Limestone-Grey
2	12	Limestone-Grey	102	110	Sandstone-Grey
12	16	Shale-Black	110	115	Shale-Grey
16	18	Limestone-Grey	115	119	Shale-Black
18	26	Shale-Grey	119	133	Shale-Grey
26	48	Limestone-Tan	133	187	Sandstone-Grey
48	49	Shale-Grey	187	205	Shale-Grey
49	65	Shale-Grey	205	207	Limestone-Grey
65	74	Shale-Black	207	208	Shale-Grey
74	77	Limestone-Tan	208	210	Limestone-Grey
77	80	Sandstone-Grey	210	220	Shale-Grey
80	88	Shale-Grey			130-140 = 2 GPM
88	91	Sandstone-Grey			140-160 = 2 "
91	92	Limestone-Grey			160-180 = 8 "
92	99	Sandstone-Grey			180-189 = 2 "

7 CONTRACTOR'S OR LANDOWNER'S CERTIFICATION: This water well was (1) constructed, (2) reconstructed, or (3) plugged under my jurisdiction and was completed on (mo/day/year) 6-27-94 and this record is true to the best of my knowledge and belief. Kansas Water Well Contractor's License No. 182 This Water Well Record was completed on (mo/day/yr) 7-19-94 under the business name of STRADER DRILLING CO., INC. by (signature) [Signature]