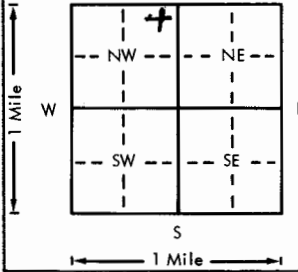
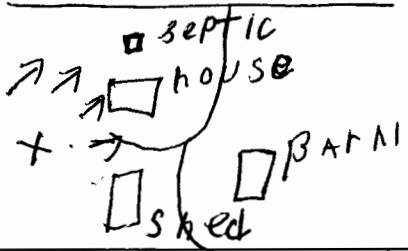


USE TYPEWRITER OR BALL
POINT PEN-PRESS FIRMLY,
PRINT CLEARLY.

WATER WELL RECORD
KSA 82a-1201-1215

Kansas Department of Health and
Environment-Division of Environment
(Water well Contractors)
Topeka, Kansas 66620

1. Location of well:	County Franklin	Fraction N.E. 1/4 N.W. 1/4	Section number 8	Township number T 18 S	Range number R 18 E/W
2. Distance and direction from nearest town or city: 1 mile East, 1 mile N. 1/2 E. - Williamsburg		3. Owner of well: Richard Talyor R.R. or street: Rural Route City, state, zip code: Williamsburg, Kansas			
4. Locate with "X" in section below: 		Sketch map: 		6. Bore hole dia. 6 1/2 in. Completion date 5-11-77 Well depth 148 ft. 9" hole	
5. Type and color of material		From	To	7. <input checked="" type="checkbox"/> Cable tool <input type="checkbox"/> Rotary <input type="checkbox"/> Driven <input type="checkbox"/> Dug <input type="checkbox"/> Hollow rod <input type="checkbox"/> Jetted <input type="checkbox"/> Bored <input type="checkbox"/> Reverse rotary	
soil		00	2	8. Use: <input type="checkbox"/> Domestic <input type="checkbox"/> Public supply <input type="checkbox"/> Industry <input type="checkbox"/> Irrigation <input type="checkbox"/> Air conditioning <input checked="" type="checkbox"/> Stock <input type="checkbox"/> Lawn <input type="checkbox"/> Oil field water <input type="checkbox"/> Other	
shelly rock		2	8	9. Casing: Material PVC Height: Above 100 Threaded <input type="checkbox"/> Welded <input type="checkbox"/> Surface 18 in. RMP <input type="checkbox"/> PVC <input checked="" type="checkbox"/> Weight 350 lbs./ft. Dia. 6 1/2 in. to 20 ft. depth Wall thickness: inches or Dia. 5 1/2 in. to 14 ft. depth gauge No. SCH. 40	
shale		8	100	10. Screen: Manufacturer's name Crown Line Type 1/16 Dia. 20 Slot/gauze 138 Length 148 Set between <input type="checkbox"/> ft. and <input type="checkbox"/> ft. Gravel pack? NO Size range of material <input type="checkbox"/>	
grey sand rock		100	143	11. Static water level: <input type="checkbox"/> mo./day/yr. 80 ft. below land surface Date 5-6-77	
shald		143	148	12. Pumping level below land surfaces: <input type="checkbox"/> ft. after <input type="checkbox"/> hrs. pumping <input type="checkbox"/> g.p.m. <input type="checkbox"/> ft. after <input type="checkbox"/> hrs. pumping <input type="checkbox"/> g.p.m. Estimated maximum yield 30 g.p.m.	
				13. Water sample submitted: <input type="checkbox"/> mo./day/yr. <input type="checkbox"/> Yes <input checked="" type="checkbox"/> No Date <input type="checkbox"/>	
				14. Well head completion: <input checked="" type="checkbox"/> Pitless adapter 18 inches above grade	
				15. Well grouted? <input checked="" type="checkbox"/> With <input checked="" type="checkbox"/> Neat cement <input type="checkbox"/> Bentonite <input type="checkbox"/> Concrete Depth: From 0 ft. to 18 ft.	
				16. Nearest source of possible contamination: ft. 150 Direction N.E. Type Feed Lot Well disinfected upon completion? <input checked="" type="checkbox"/> Yes <input type="checkbox"/> No	
				17. Pump: Not installed Manufacturer's name Red Jacket Model number 50N1-9BC HP 1/2 Volts 220 Length of drop pipe 138 ft. capacity 10 g.p.m. Type: <input checked="" type="checkbox"/> Submersible <input type="checkbox"/> Turbine <input type="checkbox"/> Jet <input type="checkbox"/> Reciprocating <input type="checkbox"/> Centrifugal <input type="checkbox"/> Other	
18. Elevation:		19. Remarks: This well has been completed. Cement slab will be poured when new house is finish		20. Water well contractor's certification: This well was drilled under my jurisdiction and this report is true to the best of my knowledge and belief. Edgar Swank Drilling 124A Business name R.R. 4 Ottawa, Kansas License No. <input type="checkbox"/> Address Edgar Swank Date 6-11-77 Signed Edgar Swank authorized representative	