

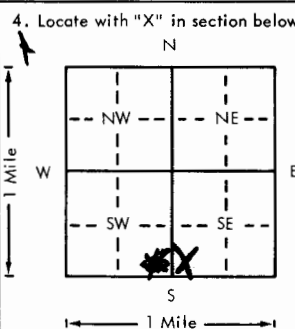
USE TYPEWRITER OR BALL  
POINT PEN-PRESS FIRMLY,  
PRINT CLEARLY.

WATER WELL RECORD  
KSA 82a-1201-1215

Kansas Department of Health and  
Environment-Division of Environment  
(Water well Contractors)  
Topeka, Kansas 66620

34

18

1. Location of well: County <u>Franklin</u> Fraction <u>SW 1/4 SE 1/4</u> Section number <u>34</u> Township number <u>T 18</u> Range number <u>S 18 E/W</u>	
2. Distance and direction from nearest town or city: <u>6 S 1 W 1/2 W</u> 3. Owner of well: <u>R. Cathey</u>	
Street address of well location if in city: <u>Homewood</u> R.R. or street: <u>Box 119</u>	
City, state, zip code: <u>Olathe, Kansas,</u>	
4. Locate with "X" in section below: Sketch map: 	
6. Bore hole dia. <u>6 1/2</u> in. Completion date <u>11-22-78</u> Well depth <u>100</u> ft. <u>9' to 20'</u>	
7. <input checked="" type="checkbox"/> Cable tool <input type="checkbox"/> Rotary <input type="checkbox"/> Driven <input type="checkbox"/> Dug <input type="checkbox"/> Hollow rod <input type="checkbox"/> Jetted <input type="checkbox"/> Bored <input type="checkbox"/> Reverse rotary	
8. Use: <input checked="" type="checkbox"/> Domestic <input type="checkbox"/> Public supply <input type="checkbox"/> Industry <input type="checkbox"/> Irrigation <input type="checkbox"/> Air conditioning <input type="checkbox"/> Stock <input type="checkbox"/> Lawn <input type="checkbox"/> Oil field water <input type="checkbox"/> Other	
9. Casing: Material <input type="checkbox"/> Height: Above or below <u>18</u> in. Threaded <input type="checkbox"/> Welded <input type="checkbox"/> Surface <u>18</u> in. RMP <input type="checkbox"/> PVC <input checked="" type="checkbox"/> Weight <u>sch 40</u> lbs./ft. Dia. <u>5</u> in. to <u>100</u> ft. depth Wall Thickness: inches or Dia. <u>5</u> in. to <u>100</u> ft. depth gage No. <u>sch 40</u>	
5. Type and color of material	From To
<u>soil &amp; clay</u>	0 10
<u>lime</u>	10 14
<u>shald</u>	14 29
<u>lime</u>	29 30
<u>shald</u>	30 100
10. Screen: Manufacturer's name <u>crown line</u> Type <u>Pvc</u> Dia. <u>5</u> Slot/gauze <u>3/8</u> Length <u>20</u> Set between <u>75</u> ft. and <u>95</u> ft. ft. and ft. Gravel pack? <u>no</u> Size range of material	
11. Static water level: <u>30</u> ft. below land surface Date <u>11-22-78</u> mo./day/yr.	
12. Pumping level below land surfaces: ft. after hrs. pumping g.p.m. ft. after hrs. pumping g.p.m. Estimated maximum yield <u>1/2</u> g.p.m.	
13. Water sample submitted: mo./day/yr. Yes <input checked="" type="checkbox"/> No <input type="checkbox"/> Date	
14. Well head completion: <u>pump house</u> Pitless adapter <u>      </u> Inches above grade	
15. Well grouted? <input checked="" type="checkbox"/> With: <input checked="" type="checkbox"/> Neat cement <input type="checkbox"/> Bentonite <input type="checkbox"/> Concrete Depth: From <u>0 to 20</u> ft. to <u>20</u> ft.	
16. Nearest source of possible contamination: ft. <u>100</u> Direction <u>east</u> Type <u>septic</u> Well disinfected upon completion? Yes <input type="checkbox"/> No <input type="checkbox"/>	
17. Pump: <input checked="" type="checkbox"/> Not installed Manufacturer's name <u>      </u> Model number <u>      </u> HP <u>      </u> Volts <u>      </u> Length of drop pipe <u>      </u> ft. capacity <u>      </u> g.p.m. Type: <input type="checkbox"/> Submersible <input type="checkbox"/> Turbine <input type="checkbox"/> Jet <input type="checkbox"/> Reciprocating <input type="checkbox"/> Centrifugal <input type="checkbox"/> Other	
(Use a second sheet if needed)	
18. Elevation:	19. Remarks:
Topography: <input type="checkbox"/> Hill <input checked="" type="checkbox"/> Slope <input type="checkbox"/> Upland <input type="checkbox"/> Valley	20. Water well contractor's certification: This well was drilled under my jurisdiction and this report is true to the best of my knowledge and belief. <u>Royce Swank Drilling</u> 371 Business name License No. <u>66067</u> Address <u>RR4, Wottawa Kan.</u> Signed <u>Royce Swank</u> Date <u>11-22-78</u> Authorized representative