WATER WELL PLUGGING RECORD Form WWC-5P KSA 82a-1212 ID NO.

1 LOCATION OF WATER WELL: County: Franklin | Fraction: ¼ SW ¼ NW ¼ NE ¼ | Section Number: 10 | Township Number: T 18 S | Range Number: 18 ☑ E ☐ W

Street/Rural Address of Well Location; if unknown, distance & direction from nearest town or intersection: If at owner's address, check here ☐ Phillips 66 Leak Site Milepost 128

1212 Old State Highway 50, Williamsburg, KS 66095

Global Positioning Systems (GPS) information:
Latitude: 38.504355 (in decimal degrees)
Longitude: -95.404316 (in decimal degrees)
Elevation: 1082
Datum: ☐ WGS84, ☐ NAD83, ☐ NAD27
Collection Method:
☐ GPS unit (Make/Model: ____)
☑ Digital Map/Photo, ☐ Topographic Map, ☐ Land Survey
Est. Accuracy: ☑ < 3 m, ☐ 3-5 m, ☐ 5-15 m, ☐ > 15 m

2 WATER WELL OWNER: Phillips 66 Company
RR#, St. Address, Box #: 1218 Phillips Building
City, State ZIP Code: Bartlesville, OK 74004

3 MARK WELL'S LOCATION WITH AN "X" IN SECTION BOX:

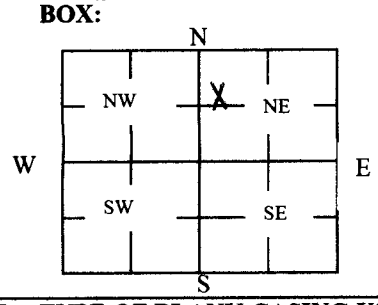

4 DEPTH OF WELL 14.77 ft.
WELL'S STATIC WATER LEVEL 9.97 ft
WELL WAS USED AS:

☐ Domestic ☐ Irrigation ☐ Feedlot ☐ Industrial
☐ Public Water Supply ☐ Oil Field Water Supply ☐ Domestic (Lawn & Garden) ☐ Air Conditioning
☐ Dewatering ☑ Monitoring ☐ Injection Well ☐ Other MW-1

Was a chemical/bacteriological sample submitted to Department? Yes ☐ No ☑

5 TYPE OF BLANK CASING USED:

☐ Steel ☑ PVC ☐ RMP (SR) ☐ ABS ☐ Wrought ☐ Asbestos-Cement ☐ Fiberglass ☐ Concrete Tile ☐ Other (Specify below)

Blank casing diameter 2 in. Was casing pulled? Yes ☐ No ☑ If yes, how much ____
Casing height above or below land surface 30 in.

6 GROUT PLUG MATERIAL: ☐ Neat cement ☐ Cement grout ☑ Bentonite ☐ Other ____

Grout Plug Intervals: From 3 ft. to 14.77 ft., From N/A ft. to N/A ft., From N/A to N/A ft.

What is the nearest source of possible contamination:
☐ Septic tank ☐ Sewer lines ☐ Watertight sewer lines ☐ Lateral lines ☐ Cess pool
☐ Seepage pit ☐ Pit privy ☐ Sewage lagoon ☐ Feedyard ☐ Livestock pens
☐ Fuel Storage ☐ Fertilizer storage ☐ Insecticide storage ☐ Abandoned water well ☐ Oil well/Gas well
☑ Other (specify below) Petroleum Pipeline
Direction from well? NW
How many feet? 420

FROM	TO	PLUGGING MATERIALS	FROM	TO	PLUGGING MATERIALS
0	3	Soil			
3	14.77	Bentonite			

7 CONTRACTOR'S OR LANDOWNER'S CERTIFICATION: This water well was plugged under my jurisdiction and was completed on (mo/day/year) 2/12/2015 and this record is true to the best of my knowledge and belief. Kansas Water Well Contractor's License No. 759. This Water Well Record was completed on (mo/day/year) 2/15/2015 under the business name of RAZEK Environmental, LLC by (signature) [signature]

INSTRUCTIONS: Use typewriter or ballpoint pen. Please press firmly and print clearly. Please fill in blanks, underline or circle the correct answers. Send one copy to Kansas Department of Health and Environment, Bureau of Water, Geology Section, 1000 SW Jackson St., Ste. 420, Topeka, Kansas 66612-1367. Telephone: 785/296-5524. Send one to Water Well Owner and retain one for your records. Visit us at http://www.kdheks.gov/waterwell/index.html.