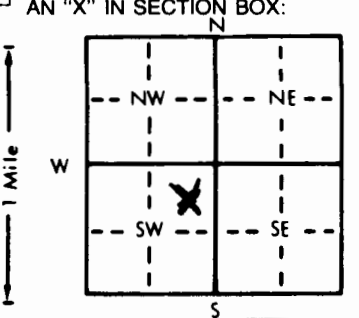


1 LOCATION OF WATER WELL: County: Franklin Fraction: NE 1/4 NE 1/4 SW 1/4 Section Number: 21 Township Number: T 18 S Range Number: R 19 EW

Distance and direction from nearest town or city street address of well if located within city?  
2124 Ellis Terrace, Princeton, KS.

2 WATER WELL OWNER: Roy Schultz  
 RR#, St. Address, Box #: 1801 S. Ash Board of Agriculture, Division of Water Resources  
 City, State, ZIP Code: Ottawa, Kansas 66067 Application Number:

3 LOCATE WELL'S LOCATION WITH AN "X" IN SECTION BOX:  


4 DEPTH OF COMPLETED WELL: 240 ft. ELEVATION:  
 Depth(s) Groundwater Encountered 1. .... ft. 2. .... ft. 3. .... ft.  
 WELL'S STATIC WATER LEVEL 0 ft. below land surface measured on mo/day/yr 7-7-95  
 Pump test data: Well water was .... ft. after .... hours pumping .... gpm  
 Est. Yield 0 gpm: Well water was .... ft. after .... hours pumping .... gpm  
 Bore Hole Diameter: 8 3/4 in. to 20 ft., and 6 3/4 in. to 240 ft.  
 WELL WATER TO BE USED AS:  
 1 Domestic     3 Feedlot     6 Oil field water supply     9 Dewatering     11 Injection well  
 2 Irrigation     4 Industrial     7 Lawn and garden only     10 Monitoring well  
 5 Public water supply     8 Air conditioning     12 Other (Specify below)  
 Was a chemical/bacteriological sample submitted to Department? Yes.....No.....; If yes, mo/day/yr sample was submitted  
 Water Well Disinfected? Yes No

5 TYPE OF BLANK CASING USED:  
 1 Steel    3 RMP (SR)    5 Wrought iron    8 Concrete tile    CASING JOINTS: Glued ..... Clamped .....  
 2 PVC    4 ABS    6 Asbestos-Cement    9 Other (specify below)    Welded .....  
 7 Fiberglass    NONE    Threaded.....  
 Blank casing diameter 0 in. to ..... ft., Dia ..... in. to ..... ft., Dia ..... in. to ..... ft.  
 Casing height above land surface 0 in., weight ..... lbs./ft. Wall thickness or gauge No. ....  
 TYPE OF SCREEN OR PERFORATION MATERIAL:  
 1 Steel    3 Stainless steel    5 Fiberglass    7 PVC    10 Asbestos-cement  
 2 Brass    4 Galvanized steel    6 Concrete tile    8 RMP (SR)    11 Other (specify) NA  
 12 None used (open hole)  
 SCREEN OR PERFORATION OPENINGS ARE:  
 1 Continuous slot    3 Mill slot    5 Gauzed wrapped    8 Saw cut    11 None (open hole)  
 2 Louvered shutter    4 Key punched    6 Wire wrapped    9 Drilled holes  
 7 Torch cut    10 Other (specify) NA  
 SCREEN-PERFORATED INTERVALS: From NA ft. to NA ft., From ..... ft. to ..... ft.  
 From ..... ft. to ..... ft., From ..... ft. to ..... ft.  
 GRAVEL PACK INTERVALS: From ..... ft. to ..... ft., From ..... ft. to ..... ft.  
 From ..... ft. to ..... ft., From ..... ft. to ..... ft.

6 GROUT MATERIAL: 1 Neat cement    2 Cement grout    3 Bentonite    4 Other .....  
 Grout Intervals: From 240 ft. to 0 ft., From ..... ft. to ..... ft., From ..... ft. to ..... ft.  
 What is the nearest source of possible contamination: NONE At time of Drilling  
 1 Septic tank    4 Lateral lines    7 Pit privy    10 Livestock pens    14 Abandoned water well  
 2 Sewer lines    5 Cess pool    8 Sewage lagoon    11 Fuel storage    15 Oil well/Gas well  
 3 Watertight sewer lines    6 Seepage pit    9 Feedyard    12 Fertilizer storage    16 Other (specify below)  
 13 Insecticide storage

Direction from well?		LITHOLOGIC LOG		PLUGGING INTERVALS	
FROM	TO	FROM	TO	FROM	TO
0	8	240	0	Bentonite	
8	16				
16	131				
131	156				
156	166				
166	171				
171	173				
173	200				
200	240				

7 CONTRACTOR'S OR LANDOWNER'S CERTIFICATION: This water well was (1) constructed, (2) reconstructed, (3) plugged under my jurisdiction and was completed on (mo/day/year) 7-7-95 and this record is true to the best of my knowledge and belief. Kansas  
 Water Well Contractor's License No. 561 This Water Well Record was completed on (mo/day/yr) 7-10-95  
 under the business name of EVANS ENERGY Development, Inc. by (signature) Scott G. Evans