
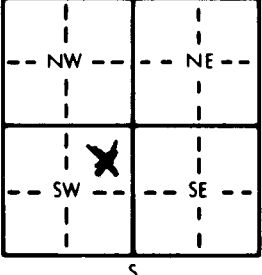


1 LOCATION OF WATER WELL: County: Franklin Fraction: NE 1/4 NE 1/4 SW 1/4 Section Number: 21 Township Number: T 18 S Range Number: R 19 EW

Distance and direction from nearest town or city street address of well if located within city? 2124 Ellis Terrace, Princeton, KS.

2 WATER WELL OWNER: Roy Schultz RR#, St. Address, Box #: 1801 S. Ash City, State, ZIP Code: Ottawa, Kansas 66067 Board of Agriculture, Division of Water Resources Application Number:

3 LOCATE WELL'S LOCATION WITH AN "X" IN SECTION BOX:  DEPTH OF COMPLETED WELL: 240 ft. ELEVATION: ft.

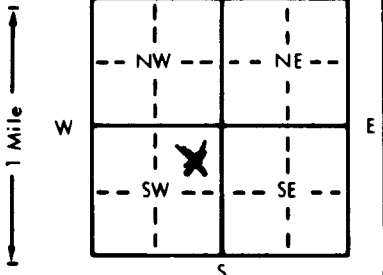

Depth(s) Groundwater Encountered 1. ft. 2. ft. 3. ft.
 WELL'S STATIC WATER LEVEL . . . 0 ft. below land surface measured on mo/day/yr 7-7-95
 Pump test data: Well water was ft. after hours pumping gpm
 Est. Yield . . . 0 . . . gpm; Well water was ft. after hours pumping gpm
 Bore Hole Diameter: 8 3/4 .in. to 20 ft., and 6 3/4 .in. to 240 ft.
 WELL WATER TO BE USED AS:
 1 Domestic 3 Feedlot 6 Oil field water supply 9 Dewatering 12 Other (Specify below)
 2 Irrigation 4 Industrial 7 Lawn and garden only 10 Monitoring well
 Was a chemical/bacteriological sample submitted to Department? Yes No; If yes, mo/day/yr sample was submitted
 Water Well Disinfected? Yes No

5 TYPE OF BLANK CASING USED:
 1 Steel 3 RMP (SR) 5 Wrought iron 8 Concrete tile CASING JOINTS: Glued Clamped
 2 PVC 4 ABS 6 Asbestos-Cement 9 Other (specify below) Welded
 Blank casing diameter . . . 0 in. to ft., Dia in. to ft., Dia in. to ft.
 Casing height above land surface . . . 0 in., weight lbs./ft. Wall thickness or gauge No.
 TYPE OF SCREEN OR PERFORATION MATERIAL:
 1 Steel 3 Stainless steel 5 Fiberglass 7 PVC 10 Asbestos-cement
 2 Brass 4 Galvanized steel 6 Concrete tile 8 RMP (SR) 11 Other (specify) . . . NA
 12 None used (open hole)

SCREEN OR PERFORATION OPENINGS ARE:
 1 Continuous slot 3 Mill slot 5 Gauzed wrapped 8 Saw cut 11 None (open hole)
 2 Louvered shutter 4 Key punched 6 Wire wrapped 9 Drilled holes
 7 Torch cut 10 Other (specify) . . . NA

SCREEN-PERFORATED INTERVALS: From . . . NA ft. to . . . NA ft., From ft. to ft.
 From ft. to ft., From ft. to ft.
 GRAVEL PACK INTERVALS: From ft. to ft., From ft. to ft.
 From ft. to ft., From ft. to ft.

6 GROUT MATERIAL: 1 Neat cement 2 Cement grout 3 Bentonite 4 Other
 Grout Intervals: From 240 ft. to . . . 0 ft., From ft. to ft., From ft. to ft.

What is the nearest source of possible contamination: NONE At time of Drilling
 1 Septic tank 4 Lateral lines 7 Pit privy 10 Livestock pens 14 Abandoned water well
 2 Sewer lines 5 Cess pool 8 Sewage lagoon 11 Fuel storage 15 Oil well/Gas well
 3 Watertight sewer lines 6 Seepage pit 9 Feedyard 12 Fertilizer storage 16 Other (specify below)
 13 Insecticide storage

| FROM | | TO | | LITHOLOGIC LOG | FROM | TO | PLUGGING INTERVALS |
|------|-----|-----|---|----------------|------|----|--------------------|
| 0 | 8 | 240 | 0 | Soil + Clay | | | Bentonite |
| 8 | 16 | | | Silty shale | | | |
| 16 | 131 | | | Shale | | | |
| 131 | 156 | | | Limestone | | | |
| 156 | 166 | | | Shale | | | |
| 166 | 171 | | | Limestone | | | |
| 171 | 173 | | | Shale | | | |
| 173 | 200 | | | Limestone | | | |
| 200 | 240 | | | Shale | | | |

7 CONTRACTOR'S OR LANDOWNER'S CERTIFICATION: This water well was (1) constructed, (2) reconstructed, (3) plugged under my jurisdiction and was completed on (mo/day/year) 7-7-95 and this record is true to the best of my knowledge and belief. Kansas Water Well Contractor's License No. 561 This Water Well Record was completed on (mo/day/yr) 7-10-95 under the business name of EVANS ENERGY Development, Inc. by (signature) Scott E. Evans

OFFICE USE ONLY