


1 LOCATION OF WATER WELL: County: <b>Franklin</b>	Fraction: <b>SE 1/4 NE 1/4 NE 1/4</b>	Section Number: <b>13</b>	Township Number: <b>18 S</b>	Range Number: <b>19 E</b>
--	---------------------------------------	---------------------------	------------------------------	---------------------------

Distance and direction from nearest town or city street address of well if located within city?

**1 MILE EAST AND 1/2 MILE SOUTH OF PRINCETON**

2 WATER WELL OWNER: RR#, St. Address, Box #: City, State, ZIP Code	Board of Agriculture, Division of Water Resources Application Number:
--	--

3 LOCATE WELL'S LOCATION WITH AN "X" IN SECTION BOX:	4 DEPTH OF COMPLETED WELL: <b>70</b> ft. ELEVATION:
--	---

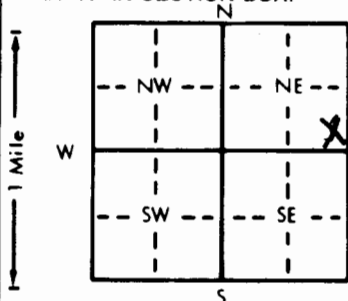

Depth(s) Groundwater Encountered **1** ft. 2. ft. 3. ft.  
WELL'S STATIC WATER LEVEL **999** ft. below land surface measured on mo/day/yr

Pump test data: Well water was \_\_\_\_\_ ft. after \_\_\_\_\_ hours pumping \_\_\_\_\_ gpm  
Est. Yield **DRY** gpm: Well water was \_\_\_\_\_ ft. after \_\_\_\_\_ hours pumping \_\_\_\_\_ gpm  
Bore Hole Diameter **8"** in. to **70'** ft. and \_\_\_\_\_ in. to \_\_\_\_\_ ft.

WELL WATER TO BE USED AS:  
 1 Domestic 3 Feedlot 6 Oil field water supply 9 Dewatering 12 Other (Specify below)  
 2 Irrigation 4 Industrial 7 Lawn and garden only 10 Monitoring well

Was a chemical/bacteriological sample submitted to Department? Yes \_\_\_\_\_ No ☒ If yes, mo/day/yr sample was submitted \_\_\_\_\_  
Water Well Disinfected? Yes ☒ No

5 TYPE OF BLANK CASING USED:	5 Wrought iron	8 Concrete tile	CASING JOINTS: Glued _____ Clamped _____
------------------------------	----------------	-----------------	--

Blank casing diameter **NA/499** in. to \_\_\_\_\_ ft. Dia \_\_\_\_\_ in. to \_\_\_\_\_ ft. Dia \_\_\_\_\_ in. to \_\_\_\_\_ ft.  
Casing height above land surface **NONE** in. weight \_\_\_\_\_ lbs./ft. Wall thickness or gauge No. \_\_\_\_\_

TYPE OF SCREEN OR PERFORATION MATERIAL:	7 PVC	10 Asbestos-cement
---	-------	--------------------

SCREEN OR PERFORATION OPENINGS ARE:  
 1 Continuous slot 3 Mill slot 5 Fiberglass 8 RMP (SR) 11 Other (specify) **NA**  
 2 Louvered shutter 4 Key punched 6 Concrete tile 9 ABS 12 None used (open hole)

SCREEN-PERFORATED INTERVALS: From **NA** ft. to **NA** ft. From \_\_\_\_\_ ft. to \_\_\_\_\_ ft.  
GRAVEL PACK INTERVALS: From \_\_\_\_\_ ft. to \_\_\_\_\_ ft. From \_\_\_\_\_ ft. to \_\_\_\_\_ ft.

6 GROUT MATERIAL:	1 Neat cement	2 Cement grout	3 Bentonite	4 Other
-------------------	---------------	----------------	-------------	---------

Grout Intervals: From **70** ft. to **67** ft. From **13** ft. to **3** ft. From \_\_\_\_\_ ft. to \_\_\_\_\_ ft.  
What is the nearest source of possible contamination:  
 1 Septic tank 4 Lateral lines 7 Pit privy 10 Livestock pens 14 Abandoned water well  
 2 Sewer lines 5 Cess pool 8 Sewage lagoon 11 Fuel storage 15 Oil well/Gas well  
 3 Watertight sewer lines 6 Seepage pit 9 Feedyard 12 Fertilizer storage 16 Other (specify below)

Direction from well? **NONE AT TIME OF Drilling** How many feet?

FROM	TO	LITHOLOGIC LOG	FROM	TO	PLUGGING INTERVALS
0	4	SOIL	70	67	CEMENT
4	7	LIME	67	13	GRAVEL
7	14	SHALE Gray			
14	22	BROKEN LIME			
22	30	SHALE			
30	31	LIME	13	3	CEMENT
31	40	WHITE SHALE			
40	41	LIME			
41	44	SHALE	3	0	SOIL
44	55	LIME			
55	56	SHALE			
56	65	LIME			
65	70	SHALE			

7 CONTRACTOR'S OR LANDOWNER'S CERTIFICATION: This water well was (1) constructed, (2) reconstructed, or (3) plugged under my jurisdiction and was completed on (mo/day/year) <b>3-5-93</b> and this record is true to the best of my knowledge and belief. Kansas Water Well Contractor's License No. <b>536</b> This Water Well Record was completed on (mo/day/yr) <b>5-5-93</b> under the business name of <b>Patchen pump &amp; well Drilling Inc</b> by (signature) <b>By E. Patchen Jr</b>
--