


1 LOCATION OF WATER WELL: County: Marion Fraction: SE 1/4 SW 1/4 SW 1/4 Section Number: 21 Township Number: T18 S Range Number: R 2 E

Distance and direction from nearest town or city street address of well if located within city?
1 1/2 S 1/4 E Durham

2 WATER WELL OWNER: James Rich
 RR#, St. Address, Box #: 3261 S 215W
 City, State, ZIP Code: Goddard, Kan 67052
 Board of Agriculture, Division of Water Resources
 Application Number:

3 LOCATE WELL'S LOCATION WITH AN "X" IN SECTION BOX:

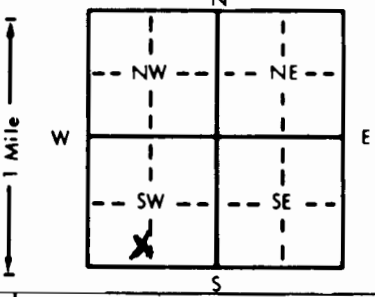

4 DEPTH OF COMPLETED WELL: 53 ft. ELEVATION:
 Depth(s) Groundwater Encountered: 1 ft. 17 ft. 44 ft. 23 ft. 89 ft.
 WELL'S STATIC WATER LEVEL: 17 ft. below land surface measured on mo/day/yr
 Pump test data: Well water was _____ ft. after _____ hours pumping _____ gpm
 Est. Yield: 10 gpm; Well water was _____ ft. after _____ hours pumping _____ gpm
 Bore Hole Diameter: 8 1/2 in. to 53 ft., and _____ in. to _____ ft.
 WELL WATER TO BE USED AS:
 1 Domestic 1 3 Feedlot 1 6 Oil field water supply 1 9 Dewatering 1 12 Other (Specify below)
 2 Irrigation 1 4 Industrial 1 7 Lawn and garden only 1 10 Monitoring well 1
 Was a chemical/bacteriological sample submitted to Department? Yes _____ No X; If yes, mo/day/yr sample was submitted _____
 Water Well Disinfected? Yes X No _____

5 TYPE OF BLANK CASING USED:
 1 Steel _____ 3 RMP (SR) _____ 5 Wrought iron _____ 8 Concrete tile _____
 2 PVC 2 4 ABS _____ 6 Asbestos-Cement _____ 9 Other (specify below) _____
 7 Fiberglass _____
 CASING JOINTS: Glued X Clamped _____
 Welded _____
 Threaded _____

Blank casing diameter: 5 in. to 43 ft., Dia _____ in. to _____ ft., Dia _____ in. to _____ ft.
 Casing height above land surface: 12 in., weight Class 160 lbs./ft. Wall thickness or gauge No. 214

TYPE OF SCREEN OR PERFORATION MATERIAL:
 1 Steel _____ 3 Stainless steel _____ 5 Fiberglass _____ 7 PVC 1 10 Asbestos-cement _____
 2 Brass _____ 4 Galvanized steel _____ 6 Concrete tile _____ 8 RMP (SR) _____ 11 Other (specify) _____
 9 ABS _____ 12 None used (open hole) _____

SCREEN OR PERFORATION OPENINGS ARE:
 1 Continuous slot _____ 3 Mill slot _____ 5 Gauzed wrapped _____ 8 Saw cut _____ 11 None (open hole) _____
 2 Louvered shutter _____ 4 Key punched _____ 6 Wire wrapped _____ 9 Drilled holes _____
 7 Torch cut _____ 10 Other (specify) _____

SCREEN-PERFORATED INTERVALS: From 43 ft. to 53 ft., From _____ ft. to _____ ft.
 From _____ ft. to _____ ft., From _____ ft. to _____ ft.
 GRAVEL PACK INTERVALS: From 20 ft. to 53 ft., From _____ ft. to _____ ft.
 From _____ ft. to _____ ft., From _____ ft. to _____ ft.

6 GROUT MATERIAL: 1 Neat cement _____ 2 Cement grout _____ 3 Bentonite 1 4 Other _____
 Grout Intervals: From 0 ft. to 20 ft., From _____ ft. to _____ ft., From _____ ft. to _____ ft.

What is the nearest source of possible contamination:
 1 Septic tank _____ 4 Lateral lines _____ 7 Pit privy _____ 10 Livestock pens _____ 14 Abandoned water well _____
 2 Sewer lines _____ 5 Cess pool _____ 8 Sewage lagoon _____ 11 Fuel storage _____ 15 Oil well/Gas well _____
 3 Watertight sewer lines _____ 6 Seepage pit _____ 9 Feedyard _____ 12 Fertilizer storage _____ 16 Other (specify below) _____
 13 Insecticide storage _____

Direction from well? In Pasture How many feet?

| FROM | TO | LITHOLOGIC LOG | FROM | TO | PLUGGING INTERVALS |
|------|----|-----------------|------|----|--------------------|
| 0 | 27 | Sandy Clay | | | |
| 27 | 44 | Blue Shale | | | |
| 44 | 50 | Crumbled Shales | | | |
| 50 | 53 | Blue Shale | | | |

7 CONTRACTOR'S OR LANDOWNER'S CERTIFICATION: This water well was (1) constructed, (2) reconstructed, or (3) plugged under my jurisdiction and was completed on (mo/day/year) 9-23-89 and this record is true to the best of my knowledge and belief. Kansas Water Well Contractor's License No. 780 This Water Well Record was completed on (mo/day/yr) 10-11-89 under the business name of Backhoe Drilling by (signature) Paul H. Backhoe