


1 LOCATION OF WATER WELL: Fraction E/2 Section Number 17 Township Number 18 Range Number 2  
 County: MARION

Distance and direction from nearest town or city street address of well if located within city?  
603 LAWRENCE AVE, DURHAM KS 67438

2 WATER WELL OWNER: GARY L. and JOANN GERRINGER  
 RR #, St. Address, Box #: 603 LAWRENCE AVE Board of Agriculture, Division of Water Resources  
 City, State, ZIP Code: DURHAM KS 67438 Application Number: \_\_\_\_\_

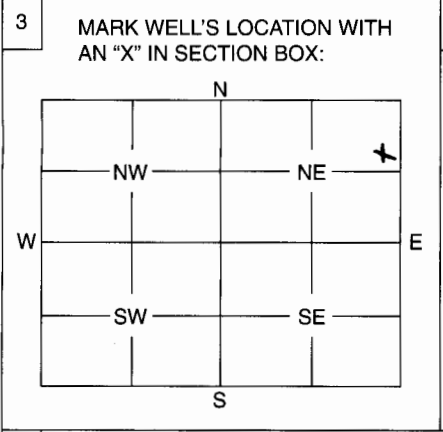

4 DEPTH OF WELL ..... 23 ..... ft.  
 WELL'S STATIC WATER LEVEL ..... 11 ..... ft.  
 WELL WAS USED AS:  
 1 Domestic                      5 Public Water Supply                      9 Dewatering  
 2 Irrigation                      6 Oil Field Water Supply                      10 Monitoring Well  
 3 Feedlot                      7 Domestic (Lawn & Garden)                      11 Injection Well  
 4 Industrial                      8 Air Conditioning                      12 Other .....  
 Was a chemical / bacteriological sample submitted to Department? Yes ..... No   
 If yes, mo/day/yr sample was submitted .....  
 Water Well Disinfected: Yes  No .....

5 TYPE OF BLANK CASING USED:  
 1 Steel      3 RMP (SR)      5 Wrought      7 Fiberglass      9 Other (Specify below) HAND DUG - ROCK  
 2 PVC      4 ABS      6 Asbestos-Cement      8 Concrete Tile  
 Blank casing diameter ..... in.      Was casing pulled? Yes ..... No .....      If yes, how much .....  
 Casing height above or below land surface ..... in.

6 GROUT PLUG MATERIAL:      1 Neat cement      2 Cement grout      3 Bentonite      4 Other .....  
 Grout Plug Intervals:      From ..... ft. to ..... ft.,      From 5 ft. to 4 ft.,      From ..... to ..... ft.  
 What is the nearest source of possible contamination:  
 1 Septic tank                      6 Seepage pit                      11 Fuel storage                      16 Other (specify below)  
 2 Sewer lines                      7 Pit privy                      12 Fertilizer storage  
 3 Watertight sewer lines                      8 Sewage lagoon                      13 Insecticide storage  
 4 Lateral lines                      9 Feedyard                      14 Abandoned water well  
 5 Cess pool                      10 Livestock pens                      15 Oil well/Gas well  
 Direction from well? .....      How many feet? .....

FROM	TO	PLUGGING MATERIALS
<u>23</u>	<u>19</u>	<u>ROCKS</u>
<u>19</u>	<u>12</u>	<u>SAND</u>
<u>12</u>	<u>5</u>	<u>CLAY</u>
<u>5</u>	<u>4</u>	<u>BENTONITE</u>
<u>4</u>	<u>0</u>	<u>TOPSOIL</u>

7 CONTRACTOR'S OF LANDOWNER'S CERTIFICATION: This water well was plugged under my jurisdiction and was completed on (mo/day/year) ..... and this record is true to the best of my knowledge and belief. Kansas Water Well Contractor's License No. .... This Water Well Record was completed on (mo/day/year) ..... under the business name of ..... by (signature) Mark Dalke FOR DALKE CONST CO. INC

INSTRUCTIONS: Use typewriter or ball point pen. Please press firmly and print clearly. Please fill in blanks, underline or circle the correct answers. Send top three copies to Kansas Department of Health and Environment, Bureau of Water, Geology Section, 1000 SW Jackson St., Ste. 420, Topeka, Kansas 66612-1367. Telephone: 785/296-5522. Send one to Water Well Owner and retain one for your records.