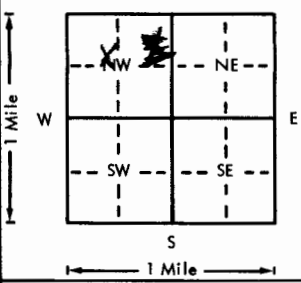
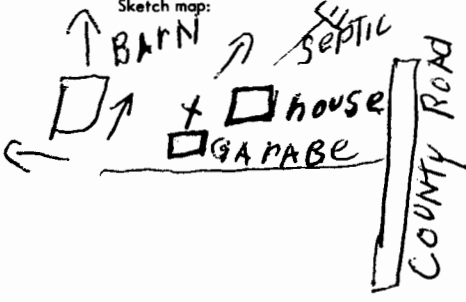


USE TYPEWRITER OR BALL POINT PEN-PRESS FIRMLY, PRINT CLEARLY.

WATER WELL RECORD
KSA 82a-1201-1215

Kansas Department of Health and Environment-Division of Environment (Water well Contractors)
Topeka, Kansas 66620

1. Location of well:	County <u>Franklin</u>	Fraction <u>N. E/4</u>	Section number <u>14</u>	Township number <u>T 15 N</u>	Range number <u>S R 07</u>	E/W
2. Distance and direction from nearest town or city: Street address of well location if in city:			3. Owner of well: <u>John H. Welster</u> R.R. or street: <u>R.R. Lane,</u> City, state, zip code: <u>Lane, Kansas</u>			
4. Locate with "X" in section below: 			Sketch map: 			6. Bore hole dia. <u>8 1/2</u> in. Completion date <u>5-30-76</u> Well depth <u>100</u> ft. <u>15-12</u>
5. Type and color of material			7. <input checked="" type="checkbox"/> Cable tool <input type="checkbox"/> Rotary <input type="checkbox"/> Driven <input type="checkbox"/> Dug <input type="checkbox"/> Hollow rod <input type="checkbox"/> Jetted <input type="checkbox"/> Bored <input type="checkbox"/> Reverse rotary	8. Use: <input checked="" type="checkbox"/> Domestic <input type="checkbox"/> Public supply <input type="checkbox"/> Industry <input type="checkbox"/> Irrigation <input type="checkbox"/> Air conditioning <input type="checkbox"/> Stock <input type="checkbox"/> Lawn <input type="checkbox"/> Oil field water <input type="checkbox"/> Other		
			9. Casing: Material <input type="checkbox"/> Height: <input checked="" type="checkbox"/> Above or below Threaded <input type="checkbox"/> Welded <input type="checkbox"/> Surface <u>2</u> in. RMP <input type="checkbox"/> PVC <input checked="" type="checkbox"/> Weight <u>350</u> lbs./ft. Dia. <u>1</u> in. to <u>160</u> ft. depth Wall Thickness: inches or Dia. <u>1</u> in. to <u> </u> ft. depth gage No. <u>305</u>	10. Screen: Manufacturer's name <u>None</u> Type <u> </u> Dia. <u> </u> Slot/gauze <u> </u> Length <u> </u> Set between <u> </u> ft. and <u> </u> ft. <u> </u> ft. and <u> </u> ft. Gravel pack? <u> </u> Size range of material <u> </u>		
18. Elevation: Topography: <input type="checkbox"/> Hill <input type="checkbox"/> Slope <input checked="" type="checkbox"/> Upland <input type="checkbox"/> Valley			From	To	11. Static water level: <u> </u> mo./day/yr. <u>10</u> ft. below land surface Date <u>5-30-76</u>	
			12. Pumping level below land surfaces: <u> </u> ft. after <u> </u> hrs. pumping <u> </u> g.p.m. <u> </u> ft. after <u> </u> hrs. pumping <u> </u> g.p.m. Estimated maximum yield <u>3</u> g.p.m.	13. Water sample submitted: <u> </u> mo./day/yr. <input type="checkbox"/> Yes <input checked="" type="checkbox"/> No Date <u> </u>	14. Well head completion: <u>Pump house</u> <input type="checkbox"/> Pitless adapter <u> </u> inches above grade	15. Well grouted? <input checked="" type="checkbox"/> With: <input checked="" type="checkbox"/> Neat cement <input type="checkbox"/> Bentonite <input type="checkbox"/> Concrete Depth: From <u>0</u> ft. to <u>15</u> ft.
19. Remarks: <u>The pump and pump house was completed 8-10-76</u>			20. Water well contractor's certification: This well was drilled under my jurisdiction and this report is true to the best of my knowledge and belief. <u>Edgar Swanb Drilling</u> <u>12/A</u> Business name <u> </u> License No. <u> </u> Address <u>R.R. Ottawa, Kansas</u> Signed <u>Edgar Swanb</u> Date <u>9-5-76</u> Authorized representative			

18 210 15 NE NW NW
T R W Sec 1/4 1/4 1/4