


1 LOCATION OF WATER WELL: County: Franklin Fraction: SE 1/4 NW 1/4 NE 1/4 Section Number: 16 Township Number: T 18 S Range Number: R 21 EW

Distance and direction from nearest town or city street address of well if located within city?  
4 miles South and 3/4 East on J. B. Drive from Rantoul, KS.

2 WATER WELL OWNER: Rudy Mames  
 RR#, St. Address, Box #: 4642 John Brown Drive  
 City, State, ZIP Code: Rantoul, KS. 66079  
 Board of Agriculture, Division of Water Resources  
 Application Number:

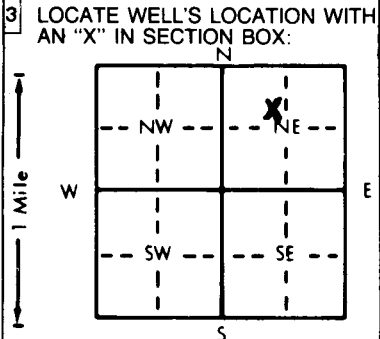

4 DEPTH OF COMPLETED WELL: 70 ft. ELEVATION:  
 Depth(s) Groundwater Encountered 1. NONE ft. 2. ft. 3. ft.  
 WELL'S STATIC WATER LEVEL: NONE ft. below land surface measured on mo/day/yr  
 Pump test data: Well water was ft. after hours pumping gpm  
 Est. Yield: NDNR gpm; Well water was ft. after hours pumping gpm  
 Bore Hole Diameter: 5 1/8 in. to ft., and in. to ft.  
 WELL WATER TO BE USED AS:  
 Domestic 3 Feedlot 6 Oil field water supply 9 Dewatering 12 Other (Specify below)  
 2 Irrigation 4 Industrial 7 Lawn and garden only 10 Monitoring well  
 Was a chemical/bacteriological sample submitted to Department? Yes No ; If yes, mo/day/yr sample was submitted  
 Water Well Disinfected? Yes No

5 TYPE OF BLANK CASING USED:  
 1 Steel 3 RMP (SR) 5 Wrought iron 8 Concrete tile CASING JOINTS: Glued Clamped  
 2 PVC 4 ABS 6 Asbestos-Cement 9 Other (specify below) Welded  
 7 Fiberglass NONE Threaded  
 Blank casing diameter: 0 in. to ft., Dia. in. to ft., Dia. in. to ft.  
 Casing height above land surface: 0 in., weight lbs./ft. Wall thickness or gauge No.  
 TYPE OF SCREEN OR PERFORATION MATERIAL:  
 1 Steel 3 Stainless steel 5 Fiberglass 7 PVC 10 Asbestos-cement  
 2 Brass 4 Galvanized steel 6 Concrete tile 8 RMP (SR) 11 Other (specify)  
 9 ABS 12 None used (open hole)  
 SCREEN OR PERFORATION OPENINGS ARE:  
 1 Continuous slot 3 Mill slot 5 Gauzed wrapped 8 Saw cut 11 None (open hole)  
 2 Louvered shutter 4 Key punched 6 Wire wrapped 9 Drilled holes  
 7 Torch cut 10 Other (specify) NONE / Closed Loop  
 SCREEN-PERFORATED INTERVALS: From 999/NA ft. to 999/NA ft., From ft. to ft.  
 GRAVEL PACK INTERVALS: From ft. to ft., From ft. to ft.

6 GROUT MATERIAL: 1 Neat cement 2 Cement grout 3 Bentonite 4 Other  
 Grout Intervals: From 70 ft. to 0 ft., From ft. to ft., From ft. to ft.  
 What is the nearest source of possible contamination: NONE  
 1 Septic tank 4 Lateral lines 7 Pit privy 10 Livestock pens 14 Abandoned water well  
 2 Sewer lines 5 Cess pool 8 Sewage lagoon 11 Fuel storage 15 Oil well/Gas well  
 3 Watertight sewer lines 6 Seepage pit 9 Feedyard 12 Fertilizer storage 16 Other (specify below)  
 13 Insecticide storage  
 Direction from well? How many feet?

FROM	TO	LITHOLOGIC LOG	FROM	TO	PLUGGING INTERVALS
<u>0</u>	<u>25</u>	<u>Soil &amp; Clay</u>	<u>70</u>	<u>0</u>	<u>High Solids Bentonite</u>
<u>25</u>	<u>68</u>	<u>Shale</u>			
<u>68</u>	<u>70</u>	<u>Limestone</u>			

7 CONTRACTOR'S OR LANDOWNER'S CERTIFICATION: This water well was (1) constructed, (2) reconstructed, or (3) plugged under my jurisdiction and was completed on (mo/day/year) 7-20-98 and this record is true to the best of my knowledge and belief, Kansas  
 Water Well Contractor's License No. 561 This Water Well Record was completed on (mo/day/yr) 7-23-98  
 under the business name of EVANS Energy Development, Inc. by (signature) [Signature]

OFFICE USE ONLY T R EW SEC