USE TYPEWRITER OR BALL POINT PEN-PRESS FIRMLY, PRINT CLEARLY.

WATER WELL RECORD
KSA 82a-1201-1215

Kansas Department of Health and Environment-Division of Environment
(Water well Contractors)
Topeka, Kansas 66620

| 1. Location of well: | County | Fraction | Section number | Township number | Range number |
|---|---|---|---|---|---|
| | Franklin | NE 1/4 ~~NW~~ 1/4 SE 1/4 | 16 | T 18 S | R 21 E/~~W~~ |

2. Distance and direction from nearest town or city: 5 South 1 East ½ North Rantoul

Street address of well location if in city:

3. Owner of well: Charlws E. Cunningham
R.R. or street: RR1
City, state, zip code: Lane, Kansas, 66042

4. Locate with "X" in section below:

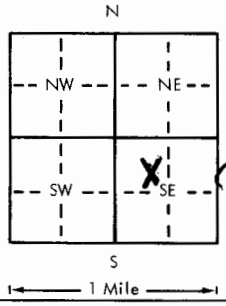


Sketch map:

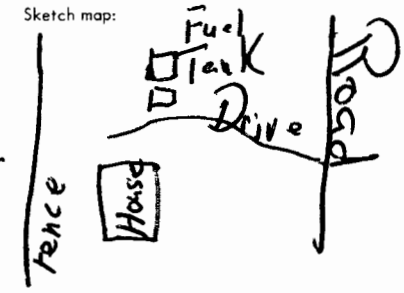


6. Bore hole dia. 6¾ in. Completion date 10-16-78
Well depth 75 ft. 75'

7. X Cable tool __ Rotary __ Driven __ Dug
__ Hollow rod __ Jetted __ Bored __ Reverse rotary

8. Use: X Domestic __ Public supply __ Industry
__ Irrigation __ Air conditioning __ Stock
__ Lawn __ Oil field water __ Other

9. Casing: Material _____ Height: Above ~~or below~~
Threaded ____ Welded ____ Surface 18 in.
RMP ____ PVC X Weight sch 40 lbs./ft.
Dia. 5 in. to 75 ft. depth Wall Thickness: inches or
Dia. ____ in. to ____ ft. depth gage No. sch 40

| 5. Type and color of material | From | To |
|---|---|---|
| soil | 0 | 3 |
| sanded ~~clay~~ mud & Gravel | 3 | 30 |
| shald | 30 | 46 |
| lime | 46 | 66 |
| shald | 66 | 75 |

(Use a second sheet if needed)

10. Screen: Manufacturer's name crown line
Type pvc Dia. 5
Slot/gauze 3/8 Length 25
Set between 30 ft. and 55 ft.
____ ft. and ____ ft.
Gravel pack yes Size range of material ⅛

11. Static water level: mo./day/yr.
25 ft. below land surface Date 10-16-78

12. Pumping level below land surfaces:
____ ft. after ____ hrs. pumping ____ g.p.m.
____ ft. after ____ hrs. pumping ____ g.p.m.
Estimated maximum yield ____ g.p.m.

13. Water sample submitted: mo./day/yr.
____ Yes ____ No Date ____

14. Well head completion:
____ Pitless adapter ____ Inches above grade

15. Well grouted? ____
With: ____ Neat cement ____ Bentonite ____ Concrete
Depth: From 0 ft. to ~~XX~~ 20

16. Nearest source of possible contamination:
ft. ____ Direction ____ Type ____
Well disinfected upon completion? ____ Yes ____ No

17. Pump: X Not installed
Manufacturer's name ____
Model number ____ HP ____ Volts ____
Length of drop pipe ____ ft. capacity ____ g.p.m.
Type:
____ Submersible ____ Turbine
____ Jet ____ Reciprocating
____ Centrifugal ____ Other

18. Elevation:
Topography:
X Hill
____ Slope
____ Upland
____ Valley

19. Remarks:
Drill in middle of a pasture.

20. Water well contractor's certification:
This well was drilled under my jurisdiction and this report is true to the best of my knowledge and belief.
Royce Swank Drilling 371
Business name License No.
Address RR4 Ottawa Ks. 66067
Signed Royce Swank Date 12-15
Authorized representative

T 18 R 21 E Sec 16 1/4 1/4 1/4 1/4

Forward the white, blue and pink copies to the Department of Health and Environment

Form WWC-5