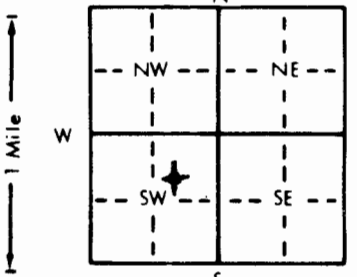


1 LOCATION OF WATER WELL: Fraction SW 1/4 NE 1/4 SW 1/4 Section Number 11 Township Number T18 S S Range Number R22 E E/W
 County: Miami

Distance and direction from nearest town or city street address of well if located within city?

820 South Sixth Street, Osawatomie, Kansas

2 WATER WELL OWNER: E.K. Campbell Co.
 RR#, St. Address, Box #: 820 South Sixth Street Board of Agriculture, Division of Water Resources
 City, State, ZIP Code: Osawatomie, KS 66064 Application Number:

3 LOCATE WELL'S LOCATION WITH AN "X" IN SECTION BOX:


4 DEPTH OF COMPLETED WELL: 20 ft. ELEVATION: apx. 860' MSL
 Depth(s) Groundwater Encountered 1. 1.57 ft. 2. ft. 3. ft.
 WELL'S STATIC WATER LEVEL . . . 1.57 . . . ft. below land surface measured on mo/day/yr 4/18/95 . . .
 Pump test data: Well water was . . . ft. after . . . hours pumping . . . gpm
 Est. Yield . . . gpm: Well water was . . . ft. after . . . hours pumping . . . gpm
 Bore Hole Diameter . . . 8 . . . in. to TD . . . ft., and . . . in. to . . . ft.
 WELL WATER TO BE USED AS: 5 Public water supply 8 Air conditioning 11 Injection well
 1 Domestic 3 Feedlot 6 Oil field water supply 9 Dewatering 12 Other (Specify below)
 2 Irrigation 4 Industrial 7 Lawn and garden only 10 Monitoring well MW-1
 Was a chemical/bacteriological sample submitted to Department? Yes . . . No. . . . If yes, mo/day/yr sample was submitted
 Water Well Disinfected? Yes No

5 TYPE OF CASING USED:
 1 Steel 3 RMP (SR) 5 Wrought iron 8 Concrete tile CASING JOINTS: Glued . . . Clamped . . .
 2 PVC 4 ABS 6 Asbestos-Cement 9 Other (specify below) Welded . . .
 7 Fiberglass Threaded.
 Blank casing diameter . . . 2 . . . in. to 2' . . . ft., Dia . . . in. to . . . ft., Dia . . . in. to . . . ft.
 Casing height above land surface . . . 2.26 . . . in., weight . . . lbs./ft. Wall thickness or gauge No. schedule 40
 TYPE OF SCREEN OR PERFORATION MATERIAL:
 1 Steel 3 Stainless steel 5 Fiberglass 8 RMP (SR) 10 Asbestos-cement
 2 Brass 4 Galvanized steel 6 Concrete tile 9 ABS 11 Other (specify) . . .
 12 None used (open hole)
 SCREEN OR PERFORATION OPENINGS ARE:
 1 Continuous slot 3 Mill slot 5 Gauzed wrapped 8 Saw cut 11 None (open hole)
 2 Louvered shutter 4 Key punched 6 Wire wrapped 9 Drilled holes
 7 Torch cut 10 Other (specify) . . .
 SCREEN-PERFORATED INTERVALS: From . . . 20 . . . ft. to . . . 2 . . . ft., From . . . ft. to . . . ft.
 From . . . ft. to . . . ft., From . . . ft. to . . . ft.
 GRAVEL PACK INTERVALS: From . . . 20 . . . ft. to . . . 1.5 . . . ft., From . . . ft. to . . . ft.
 From . . . ft. to . . . ft., From . . . ft. to . . . ft.

6 GROUT MATERIAL: 1 Neat cement 2 Cement grout 3 Bentonite 4 Other
 Grout Intervals: From . . . 1.5 . . . ft. to . . . 0 . . . ft., From . . . ft. to . . . ft., From . . . ft. to . . . ft.
 What is the nearest source of possible contamination:
 1 Septic tank 4 Lateral lines 7 Pit privy 10 Livestock pens 14 Abandoned water well
 2 Sewer lines 5 Cess pool 8 Sewage lagoon 11 Fuel storage 15 Oil well/Gas well
 3 Watertight sewer lines 6 Seepage pit 9 Feedyard 12 Fertilizer storage 16 Other (specify below)
 13 Insecticide storage
 Direction from well? South How many feet? 100

FROM	TO	LITHOLOGIC LOG	FROM	TO	PLUGGING INTERVALS
0	5'	fill material: sand, gravel			
5'	20'	dark gray to brown, stiff, moist silty clay (CL)			

7 CONTRACTOR'S OR LANDOWNER'S CERTIFICATION: This water well was (1) constructed, (2) reconstructed, or (3) plugged under my jurisdiction and was completed on (mo/day/year) 04/17/95 and this record is true to the best of my knowledge and belief. Kansas Water Well Contractor's License No. 568 This Water Well Record was completed on (mo/day/yr) 4-19-95 under the business name of MAX'S Enterprises by (signature) David Hunch