

WATER WELL RECORD Form WWC-5


Original Record Correction Change in Well Use

Division of Water Resources App. No.

Well ID

1 LOCATION OF WATER WELL: County: MIAMI	Fraction SE ¼ NE ¼ NE ¼ NW ¼	Section Number 27	Township Number T 18 S	Range Number R 24 E <input type="checkbox"/> W
--	---------------------------------	-----------------------------	----------------------------------	--

2 WELL OWNER: Last Name: Kinkade First: Mike Business Address: 13531 W. 367th Street City: LaCygne State: KS ZIP: 66040	Street or Rural Address where well is located (if unknown, distance and direction from nearest town or intersection): If at owner's address, check here: <input type="checkbox"/>
--	---

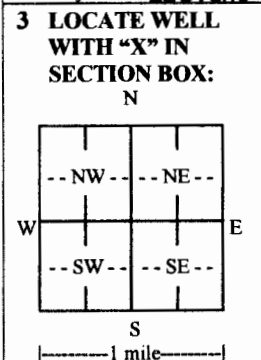

4 DEPTH OF COMPLETED WELL: **200** ft.

Depth(s) Groundwater Encountered: 1) **0** ft.
2) ft. 3) ft., or 4) Dry Well

WELL'S STATIC WATER LEVEL: **0** ft.

below land surface, measured on (mo-day-yr).....
 above land surface, measured on (mo-day-yr).....

Pump test data: Well water was **0** ft.
after..... hours pumping gpm
Well water was ft.
after..... hours pumping gpm

Estimated Yield: **0** gpm
Bore Hole Diameter: **5 5/8** in. to **200** ft. and
..... in. to ft.

5 Latitude: **38.459721** (decimal degrees)
Longitude: **-94.742953** (decimal degrees)
Horizontal Datum: WGS 84 NAD 83 NAD 27
Source for Latitude/Longitude:
 GPS (unit make/model:)
(WAAS enabled? Yes No)
 Land Survey Topographic Map
 Online Mapper:

6 Elevation: ft. Ground Level TOC
Source: Land Survey GPS Topographic Map
 Other

7 WELL WATER TO BE USED AS:

1. Domestic: <input type="checkbox"/> Household <input type="checkbox"/> Lawn & Garden <input type="checkbox"/> Livestock	5. <input type="checkbox"/> Public Water Supply: well ID	10. <input type="checkbox"/> Oil Field Water Supply: lease
2. <input type="checkbox"/> Irrigation	6. <input type="checkbox"/> Dewatering: how many wells?	11. Test Hole: well ID
3. <input type="checkbox"/> Feedlot	7. <input type="checkbox"/> Aquifer Recharge: well ID	<input type="checkbox"/> Cased <input type="checkbox"/> Uncased <input type="checkbox"/> Geotechnical
4. <input type="checkbox"/> Industrial	8. <input type="checkbox"/> Monitoring: well ID	12. Geothermal: how many bores? 5
	9. Environmental Remediation: well ID	a) Closed Loop <input type="checkbox"/> Horizontal <input checked="" type="checkbox"/> Vertical
	<input type="checkbox"/> Air Sparge <input type="checkbox"/> Soil Vapor Extraction	b) Open Loop <input type="checkbox"/> Surface Discharge <input type="checkbox"/> Inj. of Water
	<input type="checkbox"/> Recovery <input type="checkbox"/> Injection	13. <input type="checkbox"/> Other (specify):

Was a chemical/bacteriological sample submitted to KDHE? Yes No If yes, date sample was submitted:

Water well disinfected? Yes No

8 TYPE OF CASING USED: Steel PVC Other CASING JOINTS: Glued Clamped Welded Threaded

Casing diameter **3/8** in. to **200** ft., Diameter in. to ft., Diameter in. to ft.
Casing height above land surface **36** in. Weight **SDR11** lbs./ft. Wall thickness or gauge No. **160PSI**

TYPE OF SCREEN OR PERFORATION MATERIAL: NONE

Steel Stainless Steel Fiberglass PVC Other (Specify)

Brass Galvanized Steel Concrete tile None used (open hole)

SCREEN OR PERFORATION OPENINGS ARE: NONE

Continuous Slot Mill Slot Gauze Wrapped Torch Cut Drilled Holes Other (Specify)

Louvered Shutter Key Punched Wire Wrapped Saw Cut None (Open Hole)

SCREEN-PERFORATED INTERVALS: From ft. to ft., From ft. to ft., From ft. to ft.

GRAVEL PACK INTERVALS: From ft. to ft., From ft. to ft., From ft. to ft.

9 GROUT MATERIAL: Neat cement Cement grout Bentonite Other

Grout Intervals: From **200** ft. to **3** ft., From ft. to ft., From ft. to ft.

Nearest source of possible contamination:

<input type="checkbox"/> Septic Tank	<input type="checkbox"/> Lateral Lines	<input type="checkbox"/> Pit Privy	<input type="checkbox"/> Livestock Pens	<input type="checkbox"/> Insecticide Storage
<input type="checkbox"/> Sewer Lines	<input type="checkbox"/> Cess Pool	<input type="checkbox"/> Sewage Lagoon	<input type="checkbox"/> Fuel Storage	<input type="checkbox"/> Abandoned Water Well
<input type="checkbox"/> Watertight Sewer Lines	<input type="checkbox"/> Seepage Pit	<input type="checkbox"/> Feedyard	<input type="checkbox"/> Fertilizer Storage	<input type="checkbox"/> Oil Well/Gas Well
<input type="checkbox"/> Other (Specify)				

Direction from well? Distance from well? ft.

10 FROM	TO	LITHOLOGIC LOG	FROM	TO	LITHO. LOG (cont.) or PLUGGING INTERVALS
0	8	soil/clay 100-102 lime			
8	36	lime 102-200 shale	200	3	5-200' Bores Plugged With High Solid Bentonite
36	43	shale			
43	62	lime			
62	66	shale			
66	67	lime			
67	82	shale			
82	87	lime			
87	100	shale			

Notes:

11 CONTRACTOR'S OR LANDOWNER'S CERTIFICATION: This water well was constructed, reconstructed, or plugged under my jurisdiction and was completed on (mo-day-year) **01/25/2016** and this record is true to the best of my knowledge and belief. Kansas Water Well Contractor's License No. **561**. This Water Well Record was completed on (mo-day-year) **01/26/2016** under the business name of **Evans Energy Development, Inc.** Signature: *[Signature]*