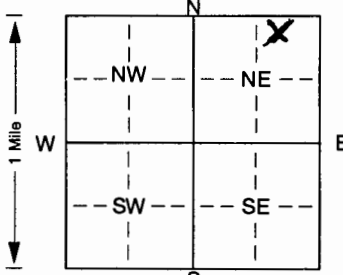


1) LOCATION OF WATER WELL: Fraction NW 1/4 Me 1/4 me 1/4 Section Number 3 Township Number T 12 S Range Number R 3 EW
 County: Marion

Distance and direction from nearest town or city street address of well if located within city?
3 S 3 1/2 E Tampa

2) WATER WELL OWNER: Stephen Klenda
 RR#, St. Address, Box # : 1664 300 St Board of Agriculture, Division of Water Resources
 City, State, ZIP Code : Lincolnville, KS 66832 Application Number:

3) LOCATE WELL'S LOCATION WITH AN "X" IN SECTION BOX:

 4) DEPTH OF COMPLETED WELL: 53 ft. ELEVATION:
 Depth(s) Groundwater Encountered 1. 5.0 ft. 2. 10-20-00 ft. 3. 20-00 ft.
 WELL'S STATIC WATER LEVEL 26 ft. below land surface measured on mo/day/yr
 Pump test data: Well water was 20 ft. after 20 hours pumping 20 gpm
 Est. Yield 20 gpm: Well water was 20 ft. after 20 hours pumping 20 gpm
 Bore Hole Diameter: 2 1/2 in. to 23 ft., and 7 in. to 55 ft.
 WELL WATER TO BE USED AS: 5 Public water supply 8 Air conditioning 11 Injection well
 1 Domestic 3 Feedlot 6 Oil field water supply 9 Dewatering 12 Other (Specify below)
 2 Irrigation 4 Industrial 7 Domestic (lawn & garden) 10 Monitoring well
 Was a chemical/bacteriological sample submitted to Department? Yes. No X; If yes, mo/day/yr sample was submitted Water Well Disinfected? Yes X No

5) TYPE OF BLANK CASING USED: 5 Wrought iron 8 Concrete tile CASING JOINTS: Glued X Clamped. Welded
 1 Steel 3 RMP (SR) 6 Asbestos-Cement 9 Other (specify below) Threaded.
 2 PVC 4 ABS 7 Fiberglass
 Blank casing diameter 5 in. to 40 ft., Dia. 12 in. to 219 lbs./ft. Wall thickness or gauge No. 219
 Casing height above land surface 12 in., weight Class 160
 TYPE OF SCREEN OR PERFORATION MATERIAL: 7 PVC 10 Asbestos-cement
 1 Steel 3 Stainless steel 5 Fiberglass 8 RMP (SR) 11 Other (specify)
 2 Brass 4 Galvanized steel 6 Concrete tile 9 ABS 12 None used (open hole)
 SCREEN OR PERFORATION OPENINGS ARE: 5 Gauzed wrapped 8 Saw cut 11 None (open hole)
 1 Continuous slot 3 Mill slot 6 Wire wrapped 9 Drilled holes
 2 Louvered shutter 4 Key punched 7 Torch cut 10 Other (specify) ft.
 SCREEN-PERFORATED INTERVALS: From 40 ft. to 53 ft., From ft. to ft.
 GRAVEL PACK INTERVALS: From ft. to ft., From ft. to ft.

6) GROUT MATERIAL: 1 Neat cement 2 Cement grout 3 Bentonite 4 Other ft.
 Grout Intervals: From 0-3 ft. to 23 ft., From ft. to ft., From ft. to ft.
 What is the nearest source of possible contamination:
 1 Septic tank 4 Lateral lines 7 Pit privy 10 Livestock pens 14 Abandoned water well
 2 Sewer lines 5 Cess pool 8 Sewage lagoon 11 Fuel storage 15 Oil well/Gas well
 3 Watertight sewer lines 6 Seepage pit 9 Feedyard 12 Fertilizer storage 16 Other (specify below)
 13 Insecticide storage
 Direction from well? S How many feet? 153'

FROM	TO	LITHOLOGIC LOG	FROM	TO	PLUGGING INTERVALS
0	35	Yellow Clay			
35	50	Blue Shale			
50	51	Water			
51	55	Gray Shale			

7) CONTRACTOR'S OR LANDOWNER'S CERTIFICATION: This water well was (1) constructed, (2) reconstructed, or (3) plugged under my jurisdiction and was completed on (mo/day/year) 10-20-00 and this record is true to the best of my knowledge and belief. Kansas Water Well Contractor's Licence No. 120 This Water Well Record was completed on (mo/day/yr) 10-20-00 under the business name of Backhus Drilling by (signature) Paul Backhus