


1 LOCATION OF WATER WELL: Fraction Ne 1/4 Ne 1/4 Se 1/4 Section Number 24 Township Number T 18 S Range Number R 3 EW
 County: Marion

Distance and direction from nearest town or city street address of well if located within city?
In Pilsen

2 WATER WELL OWNER: James honey
 RR#, St. Address, Box #: RR3 Board of Agriculture, Division of Water Resources
 City, State, ZIP Code: Marion, KS. Application Number:

3 LOCATE WELL'S LOCATION WITH AN "X" IN SECTION BOX:

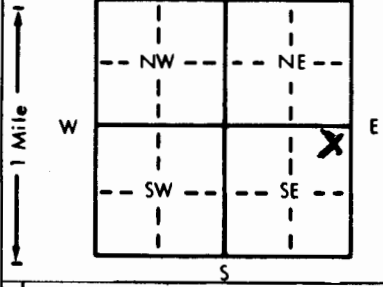

4 DEPTH OF COMPLETED WELL: 68 ft. ELEVATION:
 Depth(s) Groundwater Encountered 1 56 ft. 2. ft. 3. ft.
 WELL'S STATIC WATER LEVEL 39 ft. below land surface measured on mo/day/yr 4-19-89

Pump test data: Well water was _____ ft. after _____ hours pumping _____ gpm
 Est. Yield 2 gpm: Well water was _____ ft. after _____ hours pumping _____ gpm
 Bore Hole Diameter 2 1/2 in. to 2 5/8 in. and 7 1/2 in. to 6 1/2 in.

WELL WATER TO BE USED AS:
 1 Domestic 3 Feedlot 6 Oil field water supply 9 Dewatering 12 Other (Specify below)
 2 Irrigation 4 Industrial 7 Lawn and garden only 10 Monitoring well

Was a chemical/bacteriological sample submitted to Department? Yes _____ No X; If yes, mo/day/yr sample was submitted _____
 Water Well Disinfected? Yes X No

5 TYPE OF BLANK CASING USED:
 1 Steel 3 RMP (SR) 5 Wrought iron 8 Concrete tile CASING JOINTS: Glued X Clamped _____
 2 PVC 4 ABS 6 Asbestos-Cement 9 Other (specify below) Welded _____
 7 Fiberglass Threaded _____

Blank casing diameter 5 in. to 4 1/2 in. Dia. _____ in. to _____ in. Dia. _____ in. to _____ in. Dia. _____ in. to _____ in. Dia. _____
 Casing height above land surface 12 in., weight class 160 lbs./ft. Wall thickness or gauge No. 214

TYPE OF SCREEN OR PERFORATION MATERIAL:
 1 Steel 3 Stainless steel 5 Fiberglass 7 PVC 10 Asbestos-cement
 2 Brass 4 Galvanized steel 6 Concrete tile 8 RMP (SR) 11 Other (specify) _____
 9 ABS 12 None used (open hole)

SCREEN OR PERFORATION OPENINGS ARE:
 1 Continuous slot 3 Mill slot 5 Gauzed wrapped 8 Saw cut 11 None (open hole)
 2 Louvered shutter 4 Key punched 4 1/2 6 Wire wrapped 9 Drilled holes
 7 Torch cut 6 1/2 10 Other (specify) _____

SCREEN-PERFORATED INTERVALS: From 4 1/2 ft. to 6 1/2 ft., From _____ ft. to _____ ft., From _____ ft. to _____ ft., From _____ ft. to _____ ft.
 GRAVEL PACK INTERVALS: From 2 1/2 ft. to 6 1/2 ft., From _____ ft. to _____ ft., From _____ ft. to _____ ft., From _____ ft. to _____ ft.

6 GROUT MATERIAL: 3 Neat cement 2 1/2 Cement grout 3 Bentonite 4 Other Hole Plug
 Grout Intervals: From 3 ft. to 2 1/2 ft., From _____ ft. to _____ ft., From _____ ft. to _____ ft., From _____ ft. to _____ ft.

What is the nearest source of possible contamination:
 1 Septic tank 4 Lateral lines 7 Pit privy 10 Livestock pens 14 Abandoned water well
 2 Sewer lines 5 Cess pool 8 Sewage lagoon 11 Fuel storage 15 Oil well/Gas well
 3 Watertight sewer lines 6 Seepage pit 9 Feedyard 12 Fertilizer storage 16 Other (specify below)
 13 Insecticide storage

Direction from well? S W How many feet? 50 +

FROM	TO	LITHOLOGIC LOG	FROM	TO	PLUGGING INTERVALS
<u>0</u>	<u>45</u>	<u>Yellow Clay + mixed Shale</u>			
<u>45</u>	<u>56</u>	<u>Gray Shale</u>			
<u>56</u>	<u>57</u>	<u>Water</u>			
<u>57</u>	<u>68</u>	<u>Gray Rock</u>			

7 CONTRACTOR'S OR LANDOWNER'S CERTIFICATION: This water well was (1) constructed, (2) reconstructed, or (3) plugged under my jurisdiction and was completed on (mo/day/year) 4-19-89 and this record is true to the best of my knowledge and belief. Kansas Water Well Contractor's License No. 180 This Water Well Record was completed on (mo/day/yr) 4-25-89 under the business name of Backhoe Drilling by (signature) Gaulin Backhoe