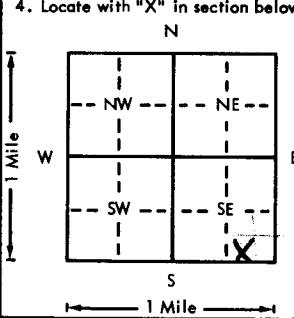


USE TYPEWRITER OR BALL POINT PEN-PRESS FIRMLY, PRINT CLEARLY.

WATER WELL RECORD  
KSA 82a-1201-1215

Kansas Department of Health and Environment-Division of Environment  
(Water well Contractors)  
Topeka, Kansas 66620

1. Location of well: County <u>Marion</u> Fraction <u>SW 1/4 SE 1/4 SE 1/4</u> Section number <u>21</u> Township number <u>T 18 S</u> Range number <u>R 3</u> <span style="float:right;">(BW)</span>	
2. Distance and direction from nearest town or city: <u>1/2 mi South</u> Street address of well location if in city: <u>3 1/4 mi West of Pilsen, Ks.</u>	
3. Owner of well: <u>Louis Vindusha</u> R.R. or street: <u>R.R. 4</u> City, state, zip code: <u>Marion Kansas 66861</u>	
4. Locate with "X" in section below: Sketch map: <div style="display: flex; align-items: center;">  <div style="margin-left: 20px; font-size: 2em; font-family: cursive;">DPC</div> </div>	
5. Type and color of material	
	From To
<u>Top Soil</u>	0 2
<u>yellow clay</u>	2 32
<u>fine sand</u>	32 36
<u>Blue Shale</u>	36 40
(Use a second sheet if needed)	
6. Bore hole dia. <u>10</u> in. Completion date <u>10-28-75</u> Well depth <u>40</u> ft.	7. <input checked="" type="checkbox"/> Cable tool <input checked="" type="checkbox"/> Rotary <input type="checkbox"/> Driven <input type="checkbox"/> Dug <input type="checkbox"/> Hollow rod <input type="checkbox"/> Jetted <input type="checkbox"/> Bored <input type="checkbox"/> Reverse rotary
8. Use: <input checked="" type="checkbox"/> Domestic <input type="checkbox"/> Public supply <input type="checkbox"/> Industry <input type="checkbox"/> Irrigation <input type="checkbox"/> Air conditioning <input type="checkbox"/> Stock <input type="checkbox"/> Lawn <input type="checkbox"/> Oil field water <input type="checkbox"/> Other	
9. Casing: Material <u>PVC</u> Height: Above or below Threaded <input type="checkbox"/> Welded <input type="checkbox"/> Surface <u>12</u> in. RMP <input type="checkbox"/> PVC <input checked="" type="checkbox"/> Weight <u>160</u> lbs./ft. Dia. <u>5</u> in. to <u>40</u> ft. depth; Wall Thickness: inches or Dia. <u>   </u> in. to <u>   </u> ft. depth; gage No. <u>4</u>	
10. Screen: Manufacturer's name <u>Pumpco Supply</u> Type <u>PVC</u> Dia. <u>5 1/8</u> Slot/gauze <u>   </u> Length <u>10</u> Set between <u>30</u> ft. and <u>40</u> ft. <u>   </u> ft. and <u>   </u> ft. Gravel pack? <input checked="" type="checkbox"/> Size range of material <u>4 to 30</u>	
11. Static water level: <u>25</u> ft. below land surface Date <u>10-28-75</u> mo./day/yr.	
12. Pumping level below land surfaces: <u>   </u> ft. after <u>   </u> hrs. pumping <u>   </u> g.p.m. <u>   </u> ft. after <u>   </u> hrs. pumping <u>   </u> g.p.m. Estimated maximum yield <u>   </u> g.p.m.	
13. Water sample submitted: <u>   </u> mo./day/yr. Yes <input checked="" type="checkbox"/> No <input type="checkbox"/> Date <u>   </u>	
14. Well head completion: <input type="checkbox"/> Pitless adapter <u>   </u> Inches above grade	
15. Well grouted? <input checked="" type="checkbox"/> With: <input type="checkbox"/> Neat cement <input type="checkbox"/> Bentonite <input checked="" type="checkbox"/> Concrete Depth: From <u>3</u> ft. to <u>13</u> ft.	
16. Nearest source of possible contamination: <u>60</u> ft. Direction <u>North</u> Type <u>Sanitary</u> Well disinfected upon completion? <input checked="" type="checkbox"/> Yes <input type="checkbox"/> No	
17. Pump: <input checked="" type="checkbox"/> Not installed Manufacturer's name <u>   </u> Model number <u>   </u> HP <u>   </u> Valts <u>   </u> Length of drop pipe <u>   </u> ft. capacity <u>   </u> g.p.m. Type: <input type="checkbox"/> Submersible <input type="checkbox"/> Turbine <input type="checkbox"/> Jet <input type="checkbox"/> Reciprocating <input type="checkbox"/> Centrifugal <input type="checkbox"/> Other	
18. Elevation: Topography: <input type="checkbox"/> Hill <input type="checkbox"/> Slope <input checked="" type="checkbox"/> Upland <input type="checkbox"/> Valley	19. Remarks: <u>Concrete Slab to be installed by owner</u>
20. Water well contractor's certification: This well was drilled under my jurisdiction and this report is true to the best of my knowledge and belief. <u>Baschus Drilling 180</u> Business name License No. <u>   </u> Address <u>Jampa, Kansas</u> Signed <u>Paul Baschus</u> Date <u>10-28-75</u> Authorized representative	

T 18 - 3 W (E) 21 SW SE SE  
R 3  
Sec 1/4 1/4 1/4

Forward the white, blue and pink copies to the Department of Health and Environment

Form WWC-5