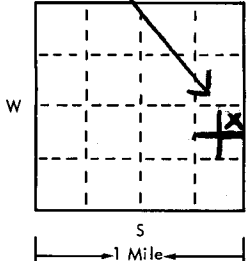
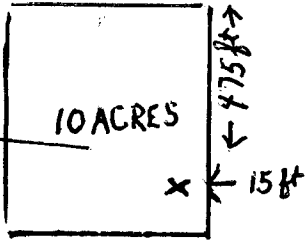


USE TYPEWRITER OR BALL POINT PEN-PRESS FIRMLY, PRINT CLEARLY.

T R EW sec 1/4 1/4 1/4 No.

WATER WELL RECORD
KSA 82a-1201-1215

Kansas State Dept. Of Health
(Water Well Contractors)
Forbes-Bldg. 740
Topeka, Kansas 66620

1 Location of well:	County Marion	Township name Clark	Fraction NE 1/4 NE 1/4 SE 1/4	Section number 24	Town number T18S	Range number R3E
Distance and direction from nearest town or city: IN Pilsen, Kans.			3 Owner of well: Hubert Steiner			
Street address of well location if in city: No Street Address			Address: Lincolnville, Kansas			
Locate with "X" in section below: 		Sketch map: 		4 Well depth: 60 ft. Date of completion 8-14-75 Well diameter: 7 1/2 in.		
2 Type and color of material		From		To		5 <input checked="" type="checkbox"/> Cable tool <input type="checkbox"/> Rotary <input type="checkbox"/> Driven <input type="checkbox"/> Dug <input type="checkbox"/> Hollow rod <input type="checkbox"/> Jetted <input type="checkbox"/> Bored <input type="checkbox"/> Reverse rotary
						6 Use: <input checked="" type="checkbox"/> Domestic <input type="checkbox"/> Public supply <input type="checkbox"/> Industry <input type="checkbox"/> Irrigation <input type="checkbox"/> Air conditioning <input type="checkbox"/> Commercial <input type="checkbox"/> Test well <input type="checkbox"/>
Good Black Soil		0		28ft		7 Casing: Material PVC Height: above/below Threaded <input type="checkbox"/> Welded <input checked="" type="checkbox"/> Surface 1 1/2 in. Diam. inside 6 in. to 37 ft. depth Drive shoe? <input type="checkbox"/> Yes <input checked="" type="checkbox"/> No 6 in. to 37 ft. depth
yellow Soil		28ft		40ft		8 Screen: Certain Teed Manufacturer Certain Teed Type _____ Dia. 6 in Slot/gauze _____ Length 23 ft Set between 37 ft. and 60 ft. Fittings: Gravel pack <input type="checkbox"/> Yes <input checked="" type="checkbox"/> No Size range of material _____
Rock (Lime Stone)		40ft		42ft		9 Static water level: 37 ft. below land surface Date 8-14-75
Water Bearing Sand & Gravel		42ft		60ft		10 Pumping level below land surfaces: No Pump installed ____ ft. after ____ hrs. pumping _____ g.p.m. ____ ft. after ____ hrs. pumping _____ g.p.m. Estimated maximum yield 15 g.p.m.
Note - Screen is made from Solid casing by boring 3/8 in. dia holes neatly in order at average of 18 holes per ft.						11 Water sample submitted: By Sand Bucket <input type="checkbox"/> Yes <input checked="" type="checkbox"/> No Date _____
						12 Well head completion: CAPPED <input type="checkbox"/> Pitless adapter 12 inches above grade
						13 Well grouted? <input checked="" type="checkbox"/> Yes <input type="checkbox"/> No <input checked="" type="checkbox"/> Neat cement <input type="checkbox"/> Bentonite <input type="checkbox"/> _____ Depth: From 0 ft. to 12 ft.
						14 Nearest source of possible contamination: ft. 53 Direction N.W. Type Septic Tank Well disinfected upon completion? <input checked="" type="checkbox"/> Yes <input type="checkbox"/> No
						15 Pump: <input checked="" type="checkbox"/> Not installed Manufacturer's name _____ Model number _____ HP _____ Volts _____ Length of drop pipe _____ ft. capacity _____ g.m.p. Type: <input type="checkbox"/> Submersible <input type="checkbox"/> Turbine <input type="checkbox"/> Jet <input type="checkbox"/> Reciprocating <input type="checkbox"/> Centrifugal <input type="checkbox"/> Other
16 Remarks: elevation Unknow						17 Water well contractor's certification: This well was drilled under my jurisdiction and this report is true to the best of my knowledge and belief. Benda Drilling 16/A Business name _____ License No. _____ Address Lincolnville, Ks. Signed Paul V. Benda Date 8-23-75 Authorized representative

Forward the white, blue and pink copies to the Kansas State Dept. Of Health.

Form WWC-5