


WATER WELL RECORD Form WWC-5 KSA 82a-1212

1 LOCATION OF WATER WELL: Fraction NW ¼ SE ¼ SW ¼ Section Number 11 Township Number T 18 S Range Number R 4 **E/W**

Distance and direction from nearest town or city street address of well if located within city?
Corner of 7th & Topeka, Lincolnville, Kansas

2 WATER WELL OWNER KDHE
 RR#, St. Address, Box # Forbes Field, Bldg. 740
 City, State, ZIP Code Topeka, Kansas
 Board of Agriculture, Division of Water Resources
 Application Number:

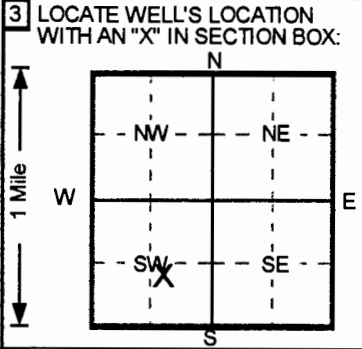

4 DEPTH OF COMPLETED WELL 86 ft. ELEVATION:

Depth(s) Groundwater Encountered 1. ft. 2. ft. 3. ft.

WELL'S STATIC WATER LEVEL ft. below land surface measured on mo/day/yr

Pump test data: Well water was NA ft. after hours pumping gpm

Est. Yield NA gpm: Well water was ft. after hours pumping gpm

Bore Hole Diameter 8 in. to 88 ft., and in. to ft.

WELL WATER TO BE USED AS:

5 Public water supply	8 Air conditioning	11 Injection well
1 Domestic	3 Feedlot	6 Oil field water supply
2 Irrigation	4 Industrial	7 Lawn and garden only
		10 Monitoring well

Was a chemical/bacteriological sample submitted to Department? Yes.....No...; If yes, mo/day/yr sample was submitted

Water Well Disinfected? Yes No

5 TYPE OF BLANK CASING USED:

1 Steel	3 RMP (SR)	5 Wrought iron	8 Concrete tile	CASING JOINTS: Glued Clamped
2 PVC	4 ABS	6 Asbestos-Cement	9 Other (specify below)	Welded
		7 Fiberglass		Threaded. <input checked="" type="checkbox"/>

Blank casing diameter 2 in. to 76 ft., Dia in. to ft., Dia in. to ft.

Casing height above land surface in., weight lbs./ft. Wall thickness or gauge No.

TYPE OF SCREEN OR PERFORATION MATERIAL

1 Steel	3 Stainless steel	5 Fiberglass	7 PVC	10 Asbestos-cement
2 Brass	4 Galvanized steel	6 Concrete tile	8 RMP (SR)	11 Other (specify)
			9 ABS	12 None used (open hole)

SCREEN OR PERFORATION OPENINGS ARE:

1 Continuous slot	3 Mill slot	5 Gauzed wrapped	8 Saw cut	11 None (open hole)
2 Louvered shutter	4 Key punched	6 Wire wrapped	9 Drilled holes	
		7 Torch cut	10 Other (specify)	

SCREEN-PERFORATED INTERVALS: From 76 ft. to 86 ft., From ft. to ft.

GRAVEL PACK INTERVALS: From 63.8 ft. to 86.5 ft., From ft. to ft.

6 GROUT MATERIAL: 1 Neat cement 2 Cement grout 3 Bentonite 4 Other

Grout Intervals: From 0 ft. to 51.7 ft., From 51.7 ft. to 63.8 ft., From ft. to ft.

What is the nearest source of possible contamination:

1 Septic tank	4 Lateral lines	7 Pit privy	10 Livestock pens	14 Abandoned water well
2 Sewer lines	5 Cess pool	8 Sewage lagoon	11 Fuel storage	15 Oil well/Gas well
3 Watertight sewer lines	6 Seepage pit	9 Feedyard	12 Fertilizer storage	16 Other (specify below)
			13 Insecticide storage	Unknown

Direction from well? How many feet?

FROM	TO	LITHOLOGIC LOG	FROM	TO	PLUGGING INTERVALS
0	3	Clay, Very Dark Grayish Brown	86	87.5	Limestone, Light Yellowish Brown
3	5.5	Clay, Brown	87.5	88	Shale, Dark Gray
5.5	7	Shale, Dark Reddish Brown			
7	17	Limestone, Greenish Gray to Light Olive Gra			
17	30	Limestone Shale, Light Olive Gray to Pale Ye			
30	44	Shale, Gray			
44	45	Limestone, Gray			
45	48	Shale, Greenish Gray to Dark Reddish Gray			
48	53.5	Shale, Dark Reddish Brown			
53.5	60.5	Shale, Dark Reddish Brown			
60.5	64.5	Shale, Greenish Gray			
64.5	72	Limestone, Light Brownish Gray			
72	76	Limestone, Pale Yellow			MW2B, Tag # , Abovegrade
76	84	Limestone, Light Brownish Gray			Project Name: BM - Lincolnville
84	86	Limestone, Very Dark Gray			GeoCore # 694, #

7 CONTRACTOR'S OR LANDOWNER'S CERTIFICATION: This water well was **1** constructed, (2) reconstructed, or (3) plugged under my jurisdiction and was completed on (mo/day/year) 8/13/98 and this record is true to the best of my knowledge and belief.

Kansas Water Well Contractor's License No. 527 This Water Well Record was completed on (mo/day/yr) 9/5/98

under the business name of **GeoCore Services, Inc.** by (signature) *Dan Kohl*

OFFICE USE ONLY
T
R
EM
SEC.
1/2
1/2
1/2