


1 LOCATION OF WATER WELL: County: Marion	Fraction SW 1/4 NW 1/4 SW 1/4	Section Number 11	Township Number T 18 S	Range Number R 4 E
--	---	-----------------------------	----------------------------------	------------------------------

Distance and direction from nearest town or city street address of well if located within city?
1 blk W, 1 blk N of Wichita Ave., Lincolnville, KS

2 WATER WELL OWNER: **KDHE**
 RR#, St. Address, Box # : **Forbes Field, Bldg 740**
 City, State, ZIP Code : **Topeka, Kansas**
 Board of Agriculture, Division of Water Resources
 Application Number:

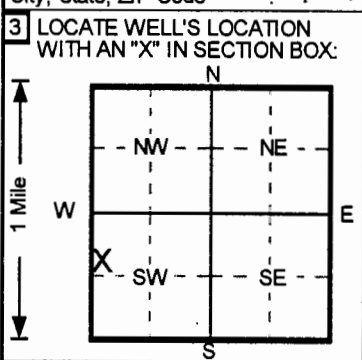

4 DEPTH OF COMPLETED WELL **95** ft. ELEVATION:

Depth(s) Groundwater Encountered 1. ft. 2. ft. 3. ft.

WELL'S STATIC WATER LEVEL ft. below land surface measured on mo/day/yr

Pump test data: Well water was **NA** ft. after hours pumping gpm

Est. Yield **NA** gpm: Well water was ft. after hours pumping gpm

Bore Hole Diameter **8** in. to **98** ft., and in. to ft.

WELL WATER TO BE USED AS: 5 Public water supply 8 Air conditioning 11 Injection well
 1 Domestic 3 Feedlot 6 Oil field water supply 9 Dewatering 12 Other (Specify below)
 2 Irrigation 4 Industrial 7 Lawn and garden only **10** Monitoring well

Was a chemical/bacteriological sample submitted to Department? Yes.....No.....; If yes, mo/day/yr sample was submitted

Water Well Disinfected? Yes No

5 TYPE OF BLANK CASING USED:

1 Steel	3 RMP (SR)	5 Wrought iron	8 Concrete tile	CASING JOINTS: Glued Clamped
2 PVC	4 ABS	6 Asbestos-Cement	9 Other (specify below)	Welded
		7 Fiberglass		Threaded. <input checked="" type="checkbox"/>

Blank casing diameter **2** in. to **85** ft., Dia in. to ft., Dia in. to ft.

Casing height above land surface **30** in., weight **Sch 40** lbs./ft. Wall thickness or gauge No.

TYPE OF SCREEN OR PERFORATION MATERIAL

1 Steel	3 Stainless steel	5 Fiberglass	7 PVC	10 Asbestos-cement
2 Brass	4 Galvanized steel	6 Concrete tile	8 RMP (SR)	11 Other (specify)
			9 ABS	12 None used (open hole)

SCREEN OR PERFORATION OPENINGS ARE:

1 Continuous slot	3 Mill slot	5 Gauzed wrapped	8 Saw cut	11 None (open hole)
2 Louvered shutter	4 Key punched	6 Wire wrapped	9 Drilled holes	
		7 Torch cut	10 Other (specify)	

SCREEN-PERFORATED INTERVALS: From **85** ft. to **95** ft., From ft. to ft.

GRAVEL PACK INTERVALS: From **71.2** ft. to **96.8** ft., From ft. to ft.

6 GROUT MATERIAL: 1 Neat cement 2 Cement grout **3** Bentonite 4 Other

Grout Intervals: From **61.2** ft. to **71.2** ft., From ft. to ft., From ft. to ft.

What is the nearest source of possible contamination:

1 Septic tank	4 Lateral lines	7 Pit privy	10 Livestock pens	14 Abandoned water well
2 Sewer lines	5 Cess pool	8 Sewage lagoon	11 Fuel storage	15 Oil well/Gas well
3 Watertight sewer lines	6 Seepage pit	9 Feedyard	12 Fertilizer storage	16 Other (specify below)
			13 Insecticide storage Unknown

Direction from well? How many feet?

FROM	TO	LITHOLOGIC LOG	FROM	TO	PLUGGING INTERVALS
0	5	Clay, Black	60.5	61.5	Siltstone, Dark Reddish Brown
5	6.5	Clay, Light Olive Brown	61.5	67.5	Shale, Grayish Green
6.5	10	Shale, Grayish Red	67.5	83	Limestone, Yellowish Gray
10	12	Limestone, Light Olive Gray	83	89.5	Limestone, Very Light Gray
12	13.5	Shale, Dark Greenish Gray	89.5	94	Limestone, Medium Dark Gray
13.5	15	Claystone, Grayish Orange	94	98	Shale, Dusky Yellow
15	21	Shale, Dusky Yellow Green			
21	25	Limestone, Grayish Orange			
25	34	Shale, Pale Yellow			
34	44.5	Shale, Medium Dark Gray			
44.5	49.5	Limestone, Medium Dark Gray			
49.5	53	Shale, Medium Light Gray			
53	56.5	Shale, Greenish Gray			MW1B, Tag # , Abovegrade
56.5	58.5	Shale, Dark Reddish Brown			Project Name: BM - Lincolnville
58.5	60.5	Sand, Brown			GeoCore # 694, #

7 CONTRACTOR'S OR LANDOWNER'S CERTIFICATION: This water well was **(1)** constructed, (2) reconstructed, or (3) plugged under my jurisdiction and was completed on (mo/day/year) **7/28/98** and this record is true to the best of my knowledge and belief.

Kansas Water Well Contractor's License No. **527** This Water Well Record was completed on (mo/day/yr) **9/5/98** under the business name of **GeoCore Services, Inc.** by (signature) *Dale Kell*

OFFICE USE ONLY
T
R
EW
SEC.