


1 LOCATION OF WATER WELL: Fraction SE 1/4 SW 1/4 SW 1/4 Section Number 11 Township Number T 18 S Range Number R 4 EW

Distance and direction from nearest town or city street address of well if located within city? 150' W of tracks on Main St., Lincolnville, KS

2 WATER WELL OWNER: KDHE RR#, St. Address, Box #: Forbes Field, Bldg 740 City, State, ZIP Code: Topeka, Kansas Board of Agriculture, Division of Water Resources Application Number:

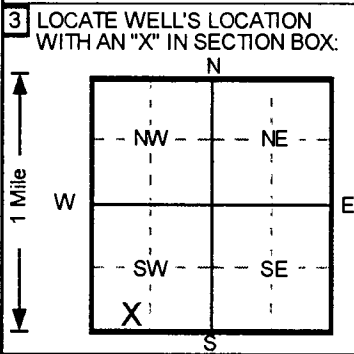

3 LOCATE WELL'S LOCATION WITH AN "X" IN SECTION BOX: 4 DEPTH OF COMPLETED WELL 30 ft. ELEVATION: ... WELL'S STATIC WATER LEVEL ... Pump test data: Well water was NA ft. after ... hours pumping ... gpm Est. Yield NA gpm: Well water was ... ft. after ... hours pumping ... gpm

5 TYPE OF BLANK CASING USED: 1 Steel 2 PVC 3 RMP (SR) 4 ABS 5 Wrought iron 6 Asbestos-Cement 7 Fiberglass 8 Concrete tile 9 Other (specify below) CASING JOINTS: Glued, Clamped, Welded, Threaded. ... TYPE OF SCREEN OR PERFORATION MATERIAL: 1 Steel 2 Brass 3 Stainless steel 4 Galvanized steel 5 Fiberglass 6 Concrete tile 7 PVC 8 RMP (SR) 9 ABS 10 Asbestos-cement 11 Other (specify) 12 None used (open hole) SCREEN OR PERFORATION OPENINGS ARE: 1 Continuous slot 2 Louvered shutter 3 Mill slot 4 Key punched 5 Gauzed wrapped 6 Wire wrapped 7 Torch cut 8 Saw cut 9 Drilled holes 10 Other (specify) 11 None (open hole) SCREEN-PERFORATED INTERVALS: FROM 20 ft. to 30 ft. GRAVEL PACK INTERVALS: FROM 16 ft. to 32 ft.

6 GROUT MATERIAL: 1 Neat cement 2 Cement grout 3 Bentonite 4 Other ... Grout Intervals: FROM 0 ft. to 11.8 ft. FROM 11.8 ft. to 16 ft. What is the nearest source of possible contamination: 1 Septic tank 2 Sewer lines 3 Watertight sewer lines 4 Lateral lines 5 Cess pool 6 Seepage pit 7 Pit privy 8 Sewage lagoon 9 Feedyard 10 Livestock pens 11 Fuel storage 12 Fertilizer storage 13 Insecticide storage 14 Abandoned water well 15 Oil well/Gas well 16 Other (specify below) Unknown

Table with columns: FROM, TO, LITHOLOGIC LOG, FROM, TO, PLUGGING INTERVALS. Data rows: 0 to 3.5 Clay, Dark Grayish - Brown; 3.5 to 6 Clay, Brown; 6 to 15 Shale, Greenish Gray; 15 to 17.5 Limestone, Pale Olive; 17.5 to 30 Limestone, Pale Yellow; 30 to 32 Shale, Dark Gray. Footer: MW4A, Abovegrade; Project Name: BM - Lincolnville; GeoCore # 694, #

7 CONTRACTOR'S OR LANDOWNER'S CERTIFICATION: This water well was (1) constructed, (2) reconstructed, or (3) plugged under my jurisdiction and was completed on (mo/day/year) 8/12/98 and this record is true to the best of my knowledge and belief. Kansas Water Well Contractor's License No. 527 This Water Well Record was completed on (mo/day/yr) Form Complete under the business name of GeoCore Services, Inc. by signature Dave Roll

OFFICE USE ONLY T R EWM SEC. 1/4 1/4 1/4