


1 LOCATION OF WATER WELL: County: Marion Fraction: Se 1/4 Se 1/4 SW 1/4 Section Number: 11 Township Number: T 18 S Range Number: R 7 E

Distance and direction from nearest town or city street address of well if located within city?
In City Lincolnville

2 WATER WELL OWNER: Albert Merton
 RR#, St. Address, Box #: 5409 Threadgill
 City, State, ZIP Code: El Paso, Texas 79924
 Board of Agriculture, Division of Water Resources
 Application Number:

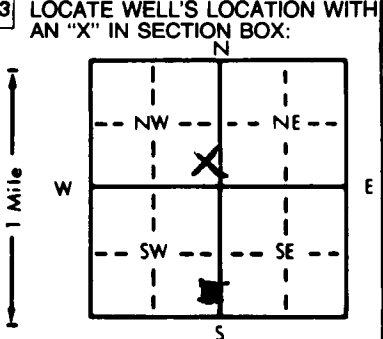

4 DEPTH OF COMPLETED WELL: 107 ft. ELEVATION: 96 ft.
 Depth(s) Groundwater Encountered: 1 75 ft. 2. 96 ft. 3. ft.
 WELL'S STATIC WATER LEVEL: 32 ft. below land surface measured on mo/day/yr 7-29-87
 Pump test data: Well water was ft. after hours pumping gpm
 Est. Yield 25 gpm Well water was ft. after hours pumping gpm
 Bore Hole Diameter: 8 3/8 in. to ft., and in. to ft.
 WELL WATER TO BE USED AS:
 1 Domestic 2 Irrigation 3 Feedlot 4 Industrial 5 Public water supply 6 Oil field water supply 7 Lawn and garden only 8 Air conditioning 9 Dewatering 10 Observation well 11 Injection well 12 Other (Specify below)
 Was a chemical/bacteriological sample submitted to Department? Yes No X; If yes, mo/day/yr sample was submitted
 Water Well Disinfected? Yes X No

5 TYPE OF BLANK CASING USED:
 1 Steel 2 PVC 3 RMP (SR) 4 ABS 5 Wrought iron 6 Asbestos-Cement 7 Fiberglass 8 Concrete tile 9 Other (specify below)
 CASING JOINTS: Glued X Clamped Welded Threaded
 Blank casing diameter: 5 in. to ft. Dia. 12 1/2 in. to ft. Dia. CLASS 160 lbs./ft. Wall thickness or gauge No. 214
 Casing height above land surface: 12 1/2 in., weight CLASS 160 lbs./ft. Wall thickness or gauge No. 214
 TYPE OF SCREEN OR PERFORATION MATERIAL:
 1 Steel 2 Brass 3 Stainless steel 4 Galvanized steel 5 Fiberglass 6 Concrete tile 7 PVC 8 RMP (SR) 9 ABS 10 Asbestos-cement 11 Other (specify) 12 None used (open hole)
 SCREEN OR PERFORATION OPENINGS ARE:
 1 Continuous slot 2 Louvered shutter 3 Mill slot 4 Key punched 5 Gauzed wrapped 6 Wire wrapped 7 Torch cut 8 Saw cut 9 Drilled holes 11 None (open hole) 10 Other (specify)
 SCREEN-PERFORATED INTERVALS: From 27 ft. to 107 ft., From ft. to ft.
 GRAVEL PACK INTERVALS: From 20 ft. to 107 ft., From ft. to ft.

6 GROUT MATERIAL: 1 Neat cement 2 Cement grout 3 Bentonite 4 Other
 Grout Intervals: From 0 ft. to 20 ft., From ft. to ft.
 What is the nearest source of possible contamination:
 1 Septic tank 2 Sewer lines 3 Watertight sewer lines 4 Lateral lines 5 Cess pool 6 Seepage pit 7 Pit privy 8 Sewage lagoon 9 Feedyard 10 Livestock pens 11 Fuel storage 12 Fertilizer storage 13 Insecticide storage 14 Abandoned water well 15 Oil well/Gas well 16 Other (specify below)

Direction from well? S How many feet? 25

| FROM | TO | LITHOLOGIC LOG | FROM | TO | LITHOLOGIC LOG |
|------|-----|-------------------|------|----|----------------|
| 0 | 3 | Clay | | | |
| 3 | 14 | lime | | | |
| 14 | 40 | Gray Clay + Shale | | | |
| 40 | 52 | Red Shale | | | |
| 52 | 75 | lime Stone | | | |
| 75 | 76 | Some Water | | | |
| 76 | 90 | Gray Shale | | | |
| 90 | 96 | lime | | | |
| 96 | 97 | Water | | | |
| 97 | 107 | Gray Shale | | | |

7 CONTRACTOR'S OR LANDOWNER'S CERTIFICATION: This water well was (1) constructed, (2) reconstructed, or (3) plugged under my jurisdiction and was completed on (mo/day/year) 7-29-87 and this record is true to the best of my knowledge and belief. Kansas Water Well Contractor's License No. 720 This Water Well Record was completed on (mo/day/yr) 7-30-87 under the business name of Bachhus Drilling by (signature) Paul Bachhus

INSTRUCTIONS: Use typewriter or ball point pen. PLEASE PRESS FIRMLY and PRINT clearly. Please fill in blanks, underline or circle the correct answers. Send top three copies to Kansas Department of Health and Environment, Bureau of Water Protection, Topeka, Kansas 66620-7320, Telephone: 913-862-9360. Send one to WATER WELL OWNER and retain one for your records.