USE TYPEWRITER OR BALL POINT PEN-PRESS FIRMLY, PRINT CLEARLY.

WATER WELL RECORD
KSA 82a-1201-1215

Kansas Department of Health and Environment-Division of Environment
(Water well Contractors)
Topeko, Kansas 66620

Location of well:	County	Fraction	Section number	Township number	Range number
X	Marion	NW 1/4 NE 1/4 SE 1/4	34	T 18 S	R 4 E/W

2. Distance and direction from nearest town or city: 4 S 1 W
Street address of well location if in city: Lincolnville

3. Owner of well: Max Loveless
R.R. or street: BR
City, state, zip code: Lincolnville Ks. 66858

4. Locate with "X" in section below:

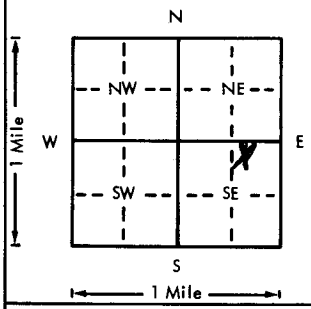

Sketch map:

6. Bore hole dia. ___ in. Completion date 7-1-77
Well depth 86 ft.

7. X Cable tool __ Rotary __ Driven __ Dug
__ Hollow rod __ Jetted __ Bored __ Reverse rotary

8. Use: X Domestic __ Public supply __ Industry
__ Irrigation __ Air conditioning __ Stock
__ Lawn __ Oil field water __ Other

9. Casing: Material PVC
Threaded ___ Welded ___
RMP ___ PVC X
Dia. 5 in. to 86 ft. depth
Dia. ___ in. to ___ ft. depth
Height: Above or below Surface 14 in.
Weight Sch 40 lbs./ft.
Wall Thickness: inches or gage No. 258

10. Screw: Manufacturer's name A.S.T.M.
Type PVC Dia. 5
Slot/gauze 8 Length 20
Set between 50 ft. and 60 ft.
70 ft. and 80 ft.
Gravel pack? X Size range of material 30

11. Static water level: 24 ft. below land surface Date 7-1-77 (mo./day/yr.)

12. Pumping level below land surfaces:
___ ft. after ___ hrs. pumping ___ g.p.m.
___ ft. after ___ hrs. pumping ___ g.p.m.
Estimated maximum yield ___ g.p.m.

13. Water sample submitted: mo./day/yr.
__ Yes X No Date

14. Well head completion:
X Pitless adapter ___ Inches above grade

15. Well grouted? X
With: X Neat cement ___ Bentonite ___ Concrete
Depth: From 25 ft. to 40 ft.

16. Nearest source of possible contamination: Sewer
ft. 100 Direction S Type Line
Well disinfected upon completion? X Yes ___ No

17. Pump: X Not installed
Manufacturer's name
Model number ___ HP ___ Volts ___
Length of drop pipe ___ ft. capacity ___ g.p.m.
Type:
__ Submersible __ Turbine
__ Jet __ Reciprocating
__ Centrifugal __ Other

5. Type and color of material	From	To
Top Soil	0	2
Yellow Clay	2	21
Lime Stone	21	26
Yellow & Red Clay	26	34
Blue Shale	34	55
Water	55	
Blue Shale	55	80
Water	80	81
Blue Shale	81	86

(Use a second sheet if needed)

18. Elevation:
Topography:
__ Hill
__ Slope
__ Upland
X Valley

19. Remarks:

20. Water well contractor's certification:
This well was drilled under my jurisdiction and this report is true to the best of my knowledge and belief.
Business name Backhus Drgl. License No. 180
Address Tampa Ks.
Signed Paul W. Backhus Date
Authorized representative 7-15-77

T 18 R 4 E/W Sec 34 1/4 NW 1/4 NE 1/4 SE 1/4

Forward the white, blue and pink copies to the Department of Health and Environment

Form WWC-5

MI-1023