


1 LOCATION OF WATER WELL: County: Marion 057 Fraction: SW 1/4 SW 1/4 NW 1/4 Section Number: 19 Township Number: T 18 S Range Number: R 4 E

Distance and direction from nearest town or city street address of well if located within city?
In Pilsen

2 WATER WELL OWNER: Tom Stroda
RR#, St. Address, Box #: B133 Board of Agriculture, Division of Water Resources
City, State, ZIP Code: Marion, KS, 66261 Application Number:

3 LOCATE WELL'S LOCATION WITH AN "X" IN SECTION BOX: 4 DEPTH OF COMPLETED WELL: 68 ft. ELEVATION: _____
Depth(s) Groundwater Encountered: 1-58 ft. 2. _____ ft. 3. _____ ft.
WELL'S STATIC WATER LEVEL: 47 ft. below land surface measured on mo/day/yr: 1-20-95

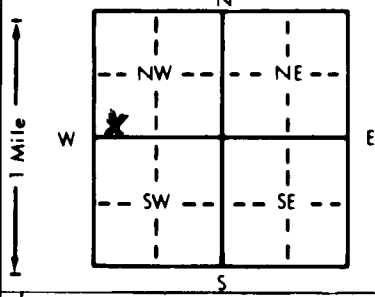

Pump test data: Well water was _____ ft. after _____ hours pumping _____ gpm
Est. Yield: 5-10 gpm. Well water was _____ ft. after _____ hours pumping _____ gpm
Bore Hole Diameter: 8 1/2 in. to 68 ft., and _____ in. to _____ ft.
WELL WATER TO BE USED AS:
1 Domestic (circled) 3 Feedlot 6 Oil field water supply 9 Dewatering 12 Other (Specify below)
2 Irrigation 4 Industrial 7 Lawn and garden only 10 Monitoring well
Was a chemical/bacteriological sample submitted to Department? Yes _____ No X; If yes, mo/day/yr sample was submitted _____
Water Well Disinfected? Yes X No _____

5 TYPE OF BLANK CASING USED:
1 Steel 3 RMP (SR) 5 Wrought iron 8 Concrete tile CASING JOINTS: Glued X Clamped _____
2 PVC (circled) 4 ABS 6 Asbestos-Cement 9 Other (specify below) Welded _____
Blank casing diameter: 5 in. to 48 ft., Dia _____ in. to _____ ft.
Casing height above land surface: 12 in., weight Class 160 lbs./ft. Wall thickness or gauge No.: 214

TYPE OF SCREEN OR PERFORATION MATERIAL:
1 Steel 3 Stainless steel 5 Fiberglass 8 RMP (SR) (circled) 10 Asbestos-cement
2 Brass 4 Galvanized steel 6 Concrete tile 9 ABS 11 Other (specify) _____
12 None used (open hole)

SCREEN OR PERFORATION OPENINGS ARE:
1 Continuous slot 3 Mill slot 5 Gauzed wrapped 8 Saw cut 11 None (open hole)
2 Louvered shutter 4 Key punched 7 Torch cut 9 Drilled holes
10 Other (specify) _____

SCREEN-PERFORATED INTERVALS: From 48 ft. to 68 ft., From _____ ft. to _____ ft.
GRAVEL PACK INTERVALS: From 23 ft. to 68 ft., From _____ ft. to _____ ft.

6 GROUT MATERIAL: 1 Neat cement 2 Cement grout 6 Bentonite (circled) 4 Other _____
Grout Intervals: From 3 ft. to 23 ft., From _____ ft. to _____ ft., From _____ ft. to _____ ft.

What is the nearest source of possible contamination:
1 Septic tank 4 Lateral lines 7 Pit privy 10 Livestock pens 14 Abandoned water well
2 Sewer lines (circled) 5 Cess pool 8 Sewage lagoon 11 Fuel storage 15 Oil well/Gas well
3 Watertight sewer lines (circled) 6 Seepage pit 9 Feedyard 12 Fertilizer storage 16 Other (specify below) _____
13 Insecticide storage
Direction from well? E How many feet? 12

FROM	TO	LITHOLOGIC LOG	FROM	TO	PLUGGING INTERVALS
0	11	Clay			
11	13	Lime			
13	52	Yellow Clay + Shale			
52	58	Blue Shale			
58		Water			
59	68	Gray Rock			

7 CONTRACTOR'S OR LANDOWNER'S CERTIFICATION: This water well was (1) constructed, (2) reconstructed, or (3) plugged under my jurisdiction and was completed on (mo/day/year) 1-20-95 and this record is true to the best of my knowledge and belief. Kansas Water Well Contractor's License No. 180 This Water Well Record was completed on (mo/day/yr) 1-21-95 under the business name of Backhus Drg. by (signature) Saul Backhus