


1 LOCATION OF WATER WELL: Fraction SW 1/4 SW 1/4 SW 1/4 Section Number 8 Township Number T 18 S Range Number R 5 E/W
 County: Marion

Distance and direction from nearest town or city street address of well if located within city?
2.5 mi E. from Lincolnville, Kansas

2 WATER WELL OWNER: Leland Albrecht
 RR#, St. Address, Box #: RR#1 Board of Agriculture, Division of Water Resources
 City, State, ZIP Code: Lincolnville, Kansas 66858 Application Number:

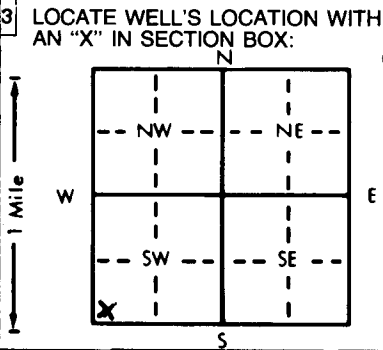

4 DEPTH OF COMPLETED WELL: 130 ft. ELEVATION: ft.
 Depth(s) Groundwater Encountered 1. 115 ft. 2. ft. 3. ft.
 WELL'S STATIC WATER LEVEL 43 ft. below land surface measured on mo/day/yr 5-30-85
 Pump test data: Well water was 105 ft. after 1 hours pumping 25 gpm
 Est. Yield 30 gpm: Well water was ft. after hours pumping gpm
 Bore Hole Diameter 8 in. to 130 ft., and in. to ft.
 WELL WATER TO BE USED AS:
 Domestic 3 Feedlot 6 Oil field water supply 9 Dewatering 12 Other (Specify below)
 2 Irrigation 4 Industrial 7 Lawn and garden only 10 Observation well
 Was a chemical/bacteriological sample submitted to Department? Yes No X; If yes, mo/day/yr sample was submitted
 Water Well Disinfected? Yes X No

5 TYPE OF BLANK CASING USED:
 1 Steel 3 RMP (SR) 5 Wrought iron 8 Concrete tile CASING JOINTS: Glued X Clamped
 2 PVC 4 ABS 6 Asbestos-Cement 9 Other (specify below) Welded
 7 Fiberglass Threaded
 Blank casing diameter 5 in. to 110 ft., Dia in. to ft., Dia in. to ft.
 Casing height above land surface 16 in., weight 2 lb-6oz lbs./ft. Wall thickness or gauge No. 15/64
 TYPE OF SCREEN OR PERFORATION MATERIAL:
 1 Steel 3 Stainless steel 5 Fiberglass 8 RMP (SR) 10 Asbestos-cement 11 Other (specify)
 2 Brass 4 Galvanized steel 6 Concrete tile 9 ABS 12 None used (open hole)
 SCREEN OR PERFORATION OPENINGS ARE:
 1 Continuous slot 3 Mill slot 5 Gauzed wrapped 8 Saw cut 11 None (open hole)
 2 Louvered shutter 4 Key punched 6 Wire wrapped 9 Drilled holes
 7 Torch cut 10 Other (specify)
 SCREEN-PERFORATED INTERVALS: From 110 ft. to 130 ft., From ft. to ft.
 From ft. to ft., From ft. to ft.
 GRAVEL PACK INTERVALS: From 110 ft. to 130 ft., From ft. to ft.
 From ft. to ft., From ft. to ft.

6 GROUT MATERIAL: 1 Neat cement 2 Cement grout 3 Bentonite 4 Other Annular - Limestone Cuttings
 Grout intervals: From 0 ft. to 12 ft., From 106 ft. to 110 ft., From ft. to ft.
 What is the nearest source of possible contamination:
 1 Septic tank 4 Lateral lines 7 Pit privy 10 Livestock pens 14 Abandoned water well
 2 Sewer lines 5 Cess pool 8 Sewage lagoon 11 Fuel storage 15 Oil well/Gas well
 3 Watertight sewer lines 6 Seepage pit 9 Feedyard 12 Fertilizer storage 6 Other (specify below)
Live Stock feed Rack
 Direction from well? How many feet? 115

FROM	TO	LITHOLOGIC LOG	FROM	TO	LITHOLOGIC LOG
0	1	Rock - Limestone	99	108	Clay - Red
1	5	Clay - Brown	108	128	Sand - Gray - White - Water
5	9	Clay - yellow	128	130	Shale - Gray
9	10	Rock - Flint			
10	20	Lime - white			
20	22	Clay - Blue Green			
22	31	Red Bed			
31	46	Lime - white			
46	47	Lost Water			
47	59	Rock - Limestone			
59	73	Clay - yellow			
73	74	Rock - Limestone			
74	78	Clay - yellow			
78	99	Shale - Gray			

7 CONTRACTOR'S OR LANDOWNER'S CERTIFICATION: This water well was (1) constructed, (2) reconstructed, or (3) plugged under my jurisdiction and was completed on (mo/day/year) 5-30-85 and this record is true to the best of my knowledge and belief. Kansas Water Well Contractor's License No. 161 This Water Well Record was completed on (mo/day/yr) 6-19-85 under the business name of Benda Drilling by (signature) Paul W. Benda

INSTRUCTIONS: Use typewriter or ball point pen, PLEASE PRESS FIRMLY and PRINT clearly. Please fill in blanks, underline or circle the correct answers. Send top three copies to Kansas Department of Health and Environment, Division of Environment, Environmental Geology Section, Topeka, KS 66620. Send one to WATER WELL OWNER and retain one for your records.