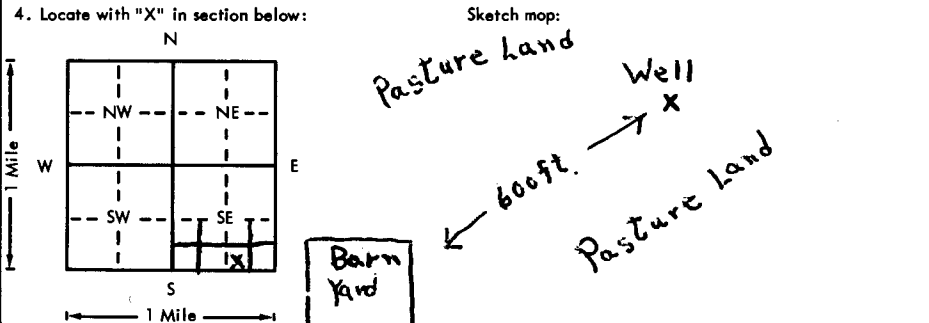


USE TYPEWRITER OR BALL POINT PEN-PRESS FIRMLY, PRINT CLEARLY.

WATER WELL RECORD
KSA 82a-1201-1215

Kansas Department of Health and Environment-Division of Environment
(Water well Contractors)
Topeka, Kansas 66620

1. Location of well:		County Marion	Fraction SW 1/4 SE 1/4 SE 1/4	Section number 11	Township number T 18 S R 5 EA	Range number
2. Distance and direction from nearest town or city: Street address of well location if in city: 6 mi E. from Lincolnville, Ks.				3. Owner of well: Frederick Hodstrom R.R. or street: Route 1 City, state, zip code: Lincolnville, Kansas 66858		
4. Locate with "X" in section below: Sketch map: 				6. Bore hole dia. 7.5 in. Completion date Well depth 70 ft. 3-17-78		
5. Type and color of material				7. <input checked="" type="checkbox"/> Cable tool <input type="checkbox"/> Rotary <input type="checkbox"/> Driven <input type="checkbox"/> Dug <input type="checkbox"/> Hollow rod <input type="checkbox"/> Jetted <input type="checkbox"/> Bored <input type="checkbox"/> Reverse rotary		
Cleaned and Re-Used Existing Well. No Samples Available.				8. Use: <input type="checkbox"/> Domestic <input type="checkbox"/> Public supply <input type="checkbox"/> Industry <input type="checkbox"/> Irrigation <input type="checkbox"/> Air conditioning <input checked="" type="checkbox"/> Stock <input type="checkbox"/> Lawn <input type="checkbox"/> Oil field water <input type="checkbox"/> Other		
				9. Casing: Material Plastic Height: Above or below Threaded <input type="checkbox"/> Welded <input checked="" type="checkbox"/> Surface 15 in. RMP <input type="checkbox"/> PVC <input checked="" type="checkbox"/> Weight 3 lbs./ft. Dia. 6 in. to 40 ft. depth Wall Thickness inches or Dia. <input type="checkbox"/> in. to <input type="checkbox"/> ft. depth gage No. 422		
				10. Screen: Manufacturer's name Certain Teed Type <input type="checkbox"/> Dia. 6 in. Slot/raze <input type="checkbox"/> Length 30 ft. Set between 40 ft. and 70 ft. <input type="checkbox"/> ft. and <input type="checkbox"/> ft. Gravel pack? NO Size range of material		
				11. Static water level: <input type="checkbox"/> mo./day/yr. 36 ft. below land surface Date 3-17-78		
				12. Pumping level below land surfaces: <input type="checkbox"/> ft. after <input type="checkbox"/> hrs. pumping <input type="checkbox"/> g.p.m. <input type="checkbox"/> ft. after <input type="checkbox"/> hrs. pumping <input type="checkbox"/> g.p.m. Estimated maximum yield 30 g.p.m.		
				13. Water sample submitted: <input type="checkbox"/> mo./day/yr. Yes <input checked="" type="checkbox"/> No Date		
				14. Well head completion: Pump Base <input type="checkbox"/> Pitless adapter 15 inches above grade		
				15. Well grouted? Yes With: <input type="checkbox"/> Neat cement <input type="checkbox"/> Bentonite <input checked="" type="checkbox"/> Concrete Depth: From 0 ft. to 12 ft.		
Screen is made from Solid Plastic Casing by boring 3/8 in Dia. holes neatly in order at average of 18 holes per ft.				16. Nearest source of possible contamination: ft. 600 Direction S.W. Type Barnyard Well disinfected upon completion? <input checked="" type="checkbox"/> Yes <input type="checkbox"/> No		
				17. Pump: Windmill <input type="checkbox"/> Not installed Manufacturer's name Dempster Model number <input type="checkbox"/> HP <input type="checkbox"/> Volts <input type="checkbox"/> Length of drop pipe 65 ft. capacity 2 to 4 g.p.m. Type: <input type="checkbox"/> Submersible <input type="checkbox"/> Turbine <input type="checkbox"/> Jet 2 1/2 x 12 Cylinder <input checked="" type="checkbox"/> Reciprocating <input type="checkbox"/> Centrifugal <input type="checkbox"/> Other		
(Use a second sheet if needed)				20. Water well contractor's certification: This well was drilled under my jurisdiction and this report is true to the best of my knowledge and belief. Benda Drilling 161 Business name License No. Address Lincolnville, Kans. Signed Paul W. Benda Date 3-20-78 Authorized representative		
18. Elevation:		19. Remarks: A large concrete base is provided to fasten the pump column base securely.				
Topography: <input type="checkbox"/> Hill <input type="checkbox"/> Slope <input checked="" type="checkbox"/> Upland <input type="checkbox"/> Valley						

T 18 S 5 R 5 EA Sec 11

Forward the white, blue and pink copies to the Department of Health and Environment

Form WWC-5