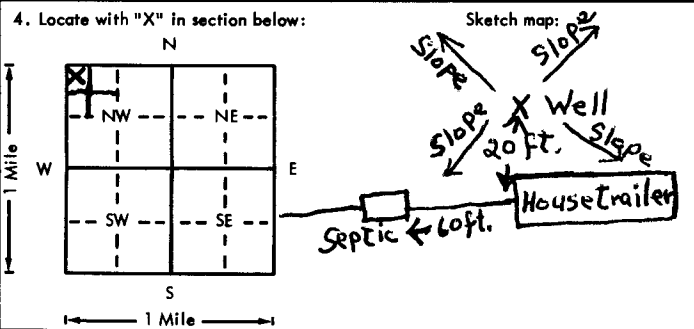


USE TYPEWRITER OR BALL POINT PEN-PRESS FIRMLY, PRINT CLEARLY.

WATER WELL RECORD  
KSA 82a-1201-1215

Kansas Department of Health and Environment-Division of Environment (Water well Contractors) Topeka, Kansas 66620

1. Location of well: County <b>Marion</b> Fraction <b>NW 1/4 NW 1/4 NW 1/4</b> Section number <b>25</b> Township number <b>T 18 S R 5</b> Range number <b>E/X</b>	
2. Distance and direction from nearest town or city: <b>6 1/2 mi. E. 2 mi. S.</b> Street address of well location if in city: <b>from Lincolnville, Ks.</b> 3. Owner of well: <b>Phillip G. Smith</b> R.R. or street: <b>Lincolnville, Ks. 66858</b> City, state, zip code:	
4. Locate with "X" in section below:  6. Bore hole dia. <b>7 1/2</b> in. Completion date <b>11-16-75</b> Well depth <b>81 1/2</b> ft.	
7. <input checked="" type="checkbox"/> Cable tool <input type="checkbox"/> Rotary <input type="checkbox"/> Driven <input type="checkbox"/> Dug <input type="checkbox"/> Hollow rod <input type="checkbox"/> Jetted <input type="checkbox"/> Bored <input type="checkbox"/> Reverse rotary	
8. Use: <input checked="" type="checkbox"/> Domestic <input type="checkbox"/> Public supply <input type="checkbox"/> Industry <input type="checkbox"/> Irrigation <input type="checkbox"/> Air conditioning <input type="checkbox"/> Stock <input type="checkbox"/> Lawn <input type="checkbox"/> Oil field water <input type="checkbox"/> Other	
9. Casing: Material <b>Plastic</b> Height: Above or below surface <input type="checkbox"/> Threading: <input type="checkbox"/> Welded <input checked="" type="checkbox"/> Surface <b>24</b> in. RMP: <input type="checkbox"/> PVC <input checked="" type="checkbox"/> Weight <b>3</b> lbs./ft. Dia. <b>6</b> in. to <b>4 1/2</b> ft. depth Wall thickness <b>3/8</b> inches or <b>3/2</b> in. Dia. <input type="checkbox"/> in. to <input type="checkbox"/> ft. depth Gauge No. <b>32</b>	
10. Screen: Manufacturer's name <b>Certain Teed</b> Type <b>PVC</b> Dia. <b>6 in</b> Slot/gauze <b>3/8</b> Length <b>40 ft.</b> Set between <b>4 1/2</b> ft. and <b>8 1/2</b> ft. Gravel pack? <b>NO</b> Size range of material _____	
11. Static water level: <b>37 1/2</b> ft. below land surface Date <b>11-16-75</b> mo./day/yr.	
12. Pumping level below land surfaces: _____ ft. after _____ hrs. pumping _____ g.p.m. Estimated maximum yield <b>12</b> g.p.m.	
13. Water sample submitted: Yes <input checked="" type="checkbox"/> No <input type="checkbox"/> Date _____ mo./day/yr.	
14. Well head completion: <b>Capped</b> Pitless adapter <b>24</b> inches above grade	
15. Well grouted? <b>Yes</b> With: <input checked="" type="checkbox"/> Neat cement <input type="checkbox"/> Bentonite <input type="checkbox"/> Concrete Depth: From <b>0</b> ft. to <b>12</b> ft.	
16. Nearest source of possible contamination: <b>Solid Sewer Line</b> ft. <b>20</b> Direction <b>N.</b> Type <b>Sewer Line</b> Well disinfected upon completion? <input checked="" type="checkbox"/> Yes <input type="checkbox"/> No	
17. Pump: <input checked="" type="checkbox"/> Not installed Manufacturer's name _____ HP _____ Volts _____ Length of drop pipe _____ ft. capacity _____ g.p.m. Type: _____ Submersible _____ Turbine _____ Jet _____ Reciprocating _____ Centrifugal _____ Other _____	
18. Elevation: Topography: <input checked="" type="checkbox"/> Hill _____ Slope _____ Upland _____ Valley _____	
19. Remarks: <b>Owner to build block well house with concrete floor</b>	
20. Water well contractor's certification: This well was drilled under my jurisdiction and this report is true to the best of my knowledge and belief. <b>Benda Drilling</b> License No. <b>161</b> Address <b>Lincolnville, Ks.</b> Signed <b>Paul W. Benda</b> Date <b>11-19-75</b> Authorized representative	

Forward the white, blue and pink copies to the Department of Health and Environment

Form WWC-5