USE TYPEWRITER OR BALL POINT PEN-PRESS FIRMLY, PRINT CLEARLY.

T	R	EW	sec	1/4	1/4	No.

WATER WELL RECORD
KSA 82a-1201-1215

Kansas State Dept. Of Health
(Water Well Contractors)
Forbes-Bldg. 740
Topeka, Kansas 66620

1 Location of well:	County	Township name	Fraction	Section number	Town number	Range number
	Chase		SW NW SE	29	18 S	R 7E

Distance and direction from nearest town or city: 9 mi N W Elmdale

Street address of well location if in city: Diamond Creek Rd

3 Owner of well: Alvin Hailey

Address: RR-1 Elmdale Ks

Locate with "X" in section below:

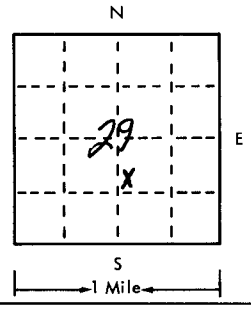

Sketch map:

4 Well depth: 77 ft. Date of completion 10/21/1976
Well diameter 10 in.

5 [X] Cable tool [ ] Rotary [ ] Driven [ ] Dug [ ] Hollow rod [ ] Jetted [ ] Bored [ ] Reverse rotary

6 Use: [X] Domestic [ ] Public supply [ ] Industry [ ] Irrigation [ ] Air conditioning [ ] Commercial [ ] Test well [ ]

7 Casing: Material PVC Height: above/~~below~~
Threaded [ ] Welded [ ] Surface 36 in.
Diam. Weight ___ lbs./ft.
8 in. to 77 ft. depth Drive shoe? [ ] Yes [X] No
___ in. to ___ ft. depth

8 Screen:
Manufacturer Slot Pert Certain Teed
Type PVC Dia. 8"
Slot gauze 18 x 6" Length 57'
Set between 17 ft. and 74 ft.
Fittings:
Gravel pack [X] Yes [ ] No Size range of material 1/4

2 Type and color of material	From	To
CL Ls Gravel Brn	0	2
CL DK Brn	2	5
Sh Red & Green	5	17
Lime & Sh	17	18
Gray Lime	18	22
Gray & Green Sh.	22	31
Lime & Shale H_2O	31	35
Gray Sh	35	46
Hard Lime	46	47
Gray Sh	47	62
Lime Lens & Sh white & Soft	62	77
77' Dense Gray Sh. T.D.		
Gravel Pack was used to stabalize		
Some Soft Shales which have caved		
and shut off wells in the Past		
(use a second sheet if needed)		

9 Static water level:
30 ft. below land surface Date 10/15/76

10 Pumping level below land surfaces:
___ ft. after ___ hrs. pumping ___ g.p.m.
___ ft. after ___ hrs. pumping ___ g.p.m.
Estimated maximum yield 1-2 g.p.m.

11 Water sample submitted:
[ ] Yes [X] No Date ___

12 Well head completion:
[X] Pitless adapter 36 Inches above grade

13 Well grouted? [X] Yes [ ] No
[X] Neat cement [ ] Bentonite [ ]
Depth: From 2 ft. to 19 ft.

14 Nearest source of possible contamination:
ft. 150 Direction NW Type Privy
Well disinfected upon completion? [X] Yes [ ] No

15 Pump: [X] Not installed
Manufacturer's name ___
Model number ___ HP ___ Volts ___
Length of drop pipe ___ ft. capacity ___ g.m.p.
Type:
[ ] Submersible [ ] Turbine
[ ] Jet [ ] Reciprocating
[ ] Certrifugal [ ] Other

16 Remarks: elevation
Diamond Creek Aera on Bench above Pasture Draw This well is about 50' From an old well producing from a shallow zone not present in this Hole

Topagraphy:
[ ] Hill
[X] Slope
[X] Upland
[ ] Valley

17 Water well contractor's certification:
This well was drilled under my jurisdiction and this report is true to the best of my knowledge and belief.
McNee Drilling 203
Business name License No.
Address Cottonwood Falls Ks
Signed [signature] Date 10/30/1976
Authorized representative

18 7E 29 SW NW SE

Forward the white, blue and pink copies to the Kansas State Dept. Of Health.

Form WWC-5

677-H