


1 LOCATION OF WATER WELL: Fraction NE 1/4 NE 1/4 SW 1/4 Section Number S Township Number T 18 S Range Number R 9 EW
 County: CHASE

Distance and direction from nearest town or city street address of well if located within city?
SOUTH WEST SIDE OF LAKE KOHLA

2 WATER WELL OWNER: THOMAS + BARBARA L. LAUGHLIN
 RR#, St. Address, Box # 1030 WEST BURNING TREE DRIVE KANSAS CITY MO 64145 of Agriculture, Division of Water Resources
 City, State, ZIP Code Application Number:

3 LOCATE WELL'S LOCATION WITH AN "X" IN SECTION BOX:

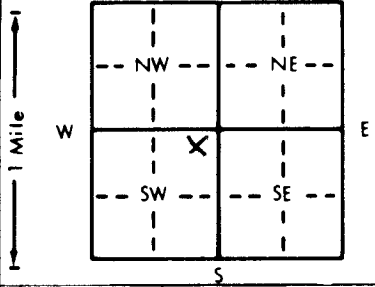

4 DEPTH OF COMPLETED WELL: 58 ft. ELEVATION:

Depth(s) Groundwater Encountered 1. UNKNOWN ft. 2. - ft. 3. - ft.
 WELL'S STATIC WATER LEVEL 20 ft. below land surface measured on mo/day/yr 08-10-95
 Pump test data: Well water was 55 ft. after 1 hours pumping 10 gpm
 Est. Yield 7 gpm: Well water was - ft. after - hours pumping - gpm
 Bore Hole Diameter: UNKNOWN ft., and - in. to - ft.

WELL WATER TO BE USED AS:
 1 Domestic 3 Feedlot 6 Oil field water supply 9 Dewatering 12 Other (Specify below)
 2 Irrigation 4 Industrial 7 Lawn and garden only 10 Monitoring well

Was a chemical/bacteriological sample submitted to Department? Yes - No X If yes, mo/day/yr sample was submitted -
 Water Well Disinfected? Yes X No -

5 TYPE OF BLANK CASING USED:
 1 Steel 3 RMP (SR) 6 Asbestos-Cement 9 Other (specify below) Welded -
 2 PVC 4 ABS 7 Fiberglass Threaded -

Blank casing diameter 5 1/6 in. to UNKNOWN ft. Dia - in. to - ft. Dia - in. to - ft.
 Casing height above land surface 14 in., weight SC# 70 lbs./ft. Wall thickness or gauge No. -

TYPE OF SCREEN OR PERFORATION MATERIAL: UNKNOWN 7 PVC 10 Asbestos-cement
 1 Steel 3 Stainless steel 5 Fiberglass 8 RMP (SR) 11 Other (specify) NA
 2 Brass 4 Galvanized steel 6 Concrete tile 9 ABS 12 None used (open hole)

SCREEN OR PERFORATION OPENINGS ARE: UNKNOWN 5 Gauzed wrapped 8 Saw cut 11 None (open hole)
 1 Continuous slot 3 Mill slot 6 Wire wrapped 9 Drilled holes 10 Other (specify) NA
 2 Louvered shutter 4 Key punched 7 Torch cut NA

SCREEN-PERFORATED INTERVALS: From UNKNOWN ft. to 999 ft. From - ft. to - ft. From - ft. to - ft.
 GRAVEL PACK INTERVALS: From UNKNOWN ft. to DOES NOT RESPOND OR SOUND LIKE IT HAS 4 GRAVEL PACK ft. From - ft. to - ft.

6 GROUT MATERIAL: 1 Neat cement 2 Cement grout 3 Bentonite 4 Other -
 Grout intervals: From UNKNOWN ft. to UNKNOWN ft. From - ft. to - ft. From - ft. to - ft.

What is the nearest source of possible contamination:
 1 Septic tank 4 Lateral lines 7 Pit privy 10 Livestock pens 14 Abandoned water well
 2 Sewer lines 5 Cess pool 8 Sewage lagoon 11 Fuel storage 15 Oil well/Gas well
 3 Watertight sewer lines 6 Seepage pit 9 Feedyard 12 Fertilizer storage 16 Other (specify below) HOLDING TANK
 13 Insecticide storage

Direction from well? N- How many feet? 50 - DOWN GRADE

FROM	TO	LITHOLOGIC LOG	FROM	TO	PLUGGING INTERVALS
<u>X</u>		<u>LITHOLOGY UNKNOWN -</u>			<u>X NO RECORDS FOUND. ONLY WELL WEST OF LINDY WELL - LAKE KOHLA</u> <u>WATER WELL CASING DOES NOT FIT THE CASING THAT WAS USED FOR THIS WELL COMPLETION.</u>

7 CONTRACTOR'S OR LANDOWNER'S CERTIFICATION: This water well was (1) constructed, (2) reconstructed or (3) plugged under my jurisdiction and was completed on (mo/day/year) 09-10-95 and this record is true to the best of my knowledge and belief. Kansas Water Well Contractor's License No. 479 This Water Well Record was completed on (mo/day/yr) 10-10-95 under the business name of EBBERTS DRILLING by (signature) Angela Ebbert