

1 LOCATION OF WATER WELL:	Fraction	Section Number	Township Number	Range Number
County: <u>CHASE</u>	<u>SW 1/4 SE 1/4 SW 1/4</u>	<u>16</u>	T <u>18</u> S	R <u>9</u> <u>EW</u>

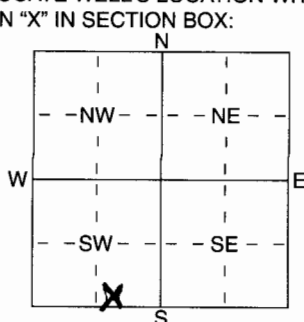
Distance and direction from nearest town or city street address of well if located within city?

From Strong City 5 miles East, 5 miles North, and 1 1/4 East2 WATER WELL OWNER: MR. STEVE KLOTZRR#, St. Address, Box # : 37980 ENFIELD LNCity, State, ZIP Code : COTTONS PORT, MO 20626

Board of Agriculture, Division of Water Resources

Application Number: _____

3 LOCATE WELL'S LOCATION WITH AN "X" IN SECTION BOX:

4 DEPTH OF COMPLETED WELL 122 ft. ELEVATION: _____Depth(s) Groundwater Encountered 18 33 ft. 2 _____ ft. 3 _____ ft.WELL'S STATIC WATER LEVEL 18 ft. below land surface measured on mo/day/yr 9/29/05

Pump test data: Well water was _____ ft. after _____ hours pumping _____ gpm

Est. Yield _____ gpm: Well water was _____ ft. after _____ hours pumping _____ gpm

WELL WATER TO BE USED AS: 5 Public water supply 8 Air conditioning 11 Injection well

Domestic 3 Feedlot 6 Oil field water supply 9 Dewatering 12 Other (Specify below)

2 Irrigation 4 Industrial 7 Domestic (lawn & garden) 10 Monitoring well _____

Was a chemical/bacteriological sample submitted to Department? Yes No; If yes, mo/day/yr sample was submittedWater Well Disinfected? Yes X No

5 TYPE OF BLANK CASING USED:

5 Wrought iron

8 Concrete tile

CASING JOINTS: Glued X Clamped _____

6 Asbestos-Cement

9 Other (specify below)

Welded _____

7 Fiberglass

Threaded _____

Blank casing diameter 5 in. to 62 ft., Dia 5 in. to 112 ft., Dia _____ in. to _____ ft.Casing height above land surface 24 in., weight _____ lbs./ft. Wall thickness or gauge No. SPR21

TYPE OF SCREEN OR PERFORATION MATERIAL:

5 Fiberglass

PVC

10 Asbestos-Cement

6 Concrete tile

8 RMP (SR)

11 Other (Specify) _____

7 Other (specify below)

9 ABS

12 None used (open hole)

SCREEN OR PERFORATION OPENINGS ARE:

5 Gauzed wrapped

8 Saw cut

11 None (open hole)

6 Wire wrapped

9 Drilled holes

4 Key punched

10 Other (specify) _____ ft.

7 Torch cut

SCREEN-PERFORATED INTERVALS: From 62 ft. to 72 ft., From _____ ft. to _____ ft.From 112 ft. to 122 ft., From _____ ft. to _____ ft.GRAVEL PACK INTERVALS: From 25 ft. to 122 ft., From _____ ft. to _____ ft.

From _____ ft. to _____ ft., From _____ ft. to _____ ft.

6 GROUT MATERIAL:

1 Neat cement

2 Cement grout

3 Bentonite

4 Other _____

Grout intervals: From 3 ft. to 25 ft., From _____ ft. to _____ ft., From _____ ft. to _____ ft.

What is the nearest source of possible contamination:

7 Pit privy

10 Livestock pens

14 Abandoned water well

8 Sewage lagoon

11 Fuel storage

15 Oil well/Gas well

9 Feedyard

12 Fertilizer storage

16 Other (specify below)

6 Seepage pit

13 Insecticide storage

1 HOUSE

Direction from well?

EASTHow many feet? 80

FROM	TO	LITHOLOGIC LOG	FROM	TO	PLUGGING INTERVALS
0	6	SOIL	102	104	LEIMSDORF
6	12	LEIMSDORF MARSHY TAN	104	122	SHALE, GRAY
12	22	SHALE, BROWN GRAY TO GRAY			
22	24	LEIMSDORF			
24	27	SHALE, GRAY			
27	30	LEIMSDORF			
30	33	SHALE, DARK GRAY TO BLACK			
33	37	SHALE, GRAY			
37	41	LEIMSDORF			
41	46	SHALE, GRAY			
46	53	LEIMSDORF			
53	62	SHALE, GRAY			
62	68	LEIMSDORF			
68	102	SHALE, GRAY			

7 CONTRACTOR'S OR LANDOWNER'S CERTIFICATION: This water well was (1) constructed, (2) reconstructed, or (3) plugged under my jurisdiction and was completed on (mo/day/year) 9/29/05 and this record is true to the best of my knowledge and belief. KansasWater Well Contractor's Licence No 760 This Water Well Record was completed on (mo/day/yr) 10/24/05under the business name of ASSOCIATED DREWING FIRM by (signature) [Signature]