


1 LOCATION OF WATER WELL: County: **CHASE** Fraction: **SE 1/4 NE 1/4 NE 1/4** Section Number: **4** Township Number: **T 18 S** Range Number: **R 9 EW**

Distance and direction from nearest town or city street address of well if located within city?
PRAIRIE ST & HWY 50 EMPORIA 9W 6N 2W 2N 1/4W LOT 13

2 WATER WELL OWNER: **AUSTIN L. COBB**
 RR#, St. Address, Box #: **1006 MARKET**
 City, State, ZIP Code: **EMPORIA KS 66801**
 Board of Agriculture, Division of Water Resources
 Application Number:

3 LOCATE WELL'S LOCATION WITH AN "X" IN SECTION BOX:

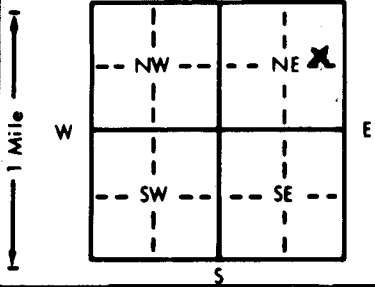

4 DEPTH OF COMPLETED WELL: **40 GL** ft. ELEVATION: _____

Depth(s) Groundwater Encountered 1. **11** ft. 2. **22** ft. 3. _____ ft.
 WELL'S STATIC WATER LEVEL: **8** ft. below land surface measured on mo/day/yr **05-11-88**
 Pump test data: Well water was _____ ft. after _____ hours pumping _____ gpm
 Est. Yield **2.0** gpm: Well water was _____ ft. after _____ hours pumping _____ gpm
 Bore Hole Diameter: **7** in. to **40** ft., and _____ in. to _____ ft.
 WELL WATER TO BE USED AS:
 5 Public water supply 8 Air conditioning 11 Injection well
 1 Domestic 3 Feedlot 6 Oil field water supply 9 Dewatering 12 Other (Specify below)
 2 Irrigation 4 Industrial 7 Lawn and garden only 10 Observation well **NA**
 Was a chemical/bacteriological sample submitted to Department? Yes _____ No ; If yes, mo/day/yr sample was submitted _____
 Water Well Disinfected? Yes _____ No

5 TYPE OF BLANK CASING USED:
 1 Steel 3 RMP (SR) 5 Wrought iron 8 Concrete tile CASING JOINTS: Glued Clamped _____
 2 PVC 4 ABS 6 Asbestos-Cement 9 Other (specify below) Welded _____
 7 Fiberglass **NA** Threaded _____

Blank casing diameter: **5** in. to **40** ft., Dia. _____ in. to _____ ft., Dia. _____ in. to _____ ft.
 Casing height above land surface: **1' BGL-PIT** in., weight **SCH 40** lbs./ft. Wall thickness or gauge No. _____

TYPE OF SCREEN OR PERFORATION MATERIAL:
 1 Steel 3 Stainless steel 5 Fiberglass 8 RMP (SR) 10 Asbestos-cement
 2 Brass 4 Galvanized steel 6 Concrete tile 9 ABS 11 Other (specify) _____
 12 None used (open hole)

SCREEN OR PERFORATION OPENINGS ARE:
 1 Continuous slot 3 Mill slot 5 Gauzed wrapped 8 Saw cut 11 None (open hole)
 2 Louvered shutter 4 Key punched 6 Wire wrapped 9 Drilled holes
 7 Torch cut 10 Other (specify) **NA**

SCREEN-PERFORATED INTERVALS: From **20** ft. to **40** ft., From _____ ft. to _____ ft.
 From _____ ft. to _____ ft., From _____ ft. to _____ ft.
 GRAVEL PACK INTERVALS: From **20** ft. to **40** ft., From _____ ft. to _____ ft.
 From _____ ft. to _____ ft., From _____ ft. to _____ ft.

6 GROUT MATERIAL: 1 Neat cement 2 Cement grout 3 Bentonite 4 Other **NA**
 Grout Intervals: From **20** ft. to **2** ft., From _____ ft. to _____ ft., From _____ ft. to _____ ft.

What is the nearest source of possible contamination:
 1 Septic tank 4 Lateral lines 7 Pit privy 10 Livestock pens 14 Abandoned water well
 2 Sewer lines 5 Cess pool 8 Sewage lagoon 11 Fuel storage 15 Oil well/Gas well
 3 Watertight sewer lines 6 Seepage pit 9 Feedyard 12 Fertilizer storage 16 Other (specify below)
 13 Insecticide storage **NA**
 Direction from well? **SE & SW** How many feet? **50**

FROM	TO	LITHOLOGIC LOG	FROM	TO	LITHOLOGIC LOG
0	20	NO RECORDS - WELL DRILLED BEFORE 1962 - QUAL. LITHO GAGE MATERIAL - TRUSTED OUT - NO GROUT OR PACK FOUND IN OLD WELL BORE - MOST OF TOP 20' APPEARS TO BE LIME STONE -			OTHER WELLS IN AREA WITH SAME PROBLEM - 300' OR SO FROM SAID PROPERTY
					PH D.P. 05-18-88
					296-1500 5523

7 CONTRACTOR'S OR LANDOWNER'S CERTIFICATION: This water well was (1) constructed, (2) reconstructed, or (3) plugged under my jurisdiction and was completed on (mo/day/year) **05-18-88** and this record is true to the best of my knowledge and belief. Kansas Water Well Contractor's License No. **479** This Water Well Record was completed on (mo/day/yr) **05-18-88** under the business name of **EBBERTS DRILLING** by (signature) **Angus Ebberts**

INSTRUCTIONS: Use typewriter or ball point pen. PLEASE PRESS FIRMLY and PRINT clearly. Please fill in blanks, underline or circle the correct answers. Send top three copies to Kansas Department of Health and Environment, Office of Oil Field and Environmental Geology, Regulation and Permitting Section, Topeka, Kansas 66620-7500, Telephone: 913-862-9360. Send one to WATER WELL OWNER and retain one for your records.

296-1500 - - 5523

OFFICE USE ONLY
T
R
EW
SEC.
VA
VA
VA