WATER WELL RECORD Form WWC-5 KSA 82a-1212 ✓

1 LOCATION OF WATER WELL: County: Chase | Fraction: NE ¼ NW ¼ NE ¼ | Section Number: 24 | Township Number: T 18 S | Range Number: R 9 (E) W

Distance and direction from nearest town or city street address of well if located within city?
4 mile North & 3/4 Mile East of Toledo

2 WATER WELL OWNER: Dalas Graybeal
RR#, St. Address, Box # : Box 197
City, State, ZIP Code : Neosho Rapids, Ks 66864
Board of Agriculture, Division of Water Resources Application Number:

3 LOCATE WELL'S LOCATION WITH AN "X" IN SECTION BOX:

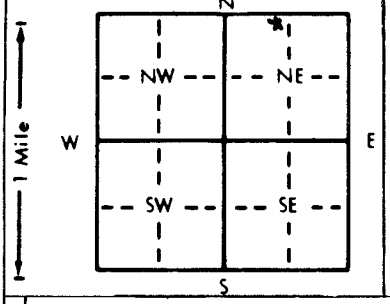

4 DEPTH OF COMPLETED WELL 80 ft. ELEVATION:
Depth(s) Groundwater Encountered 1. 47.5 ft. 2. ft. 3. ft.
WELL'S STATIC WATER LEVEL 20.5 ft. below land surface measured on mo/day/yr Jun 1 90
Pump test data: Well water was ft. after hours pumping gpm
Est. Yield 11 gpm: Well water was ft. after hours pumping gpm
Bore Hole Diameter 8 5/8 in. to 24 ft., and in. to ft.
WELL WATER TO BE USED AS: 5 Public water supply 8 Air conditioning 11 Injection well
(1) Domestic 3 Feedlot 6 Oil field water supply 9 Dewatering 12 Other (Specify below)
2 Irrigation 4 Industrial 7 Lawn and garden only 10 Monitoring well
Was a chemical/bacteriological sample submitted to Department? Yes No X ; If yes, mo/day/yr sample was submitted Water Well Disinfected? (Yes) No

5 TYPE OF BLANK CASING USED: 5 Wrought iron 8 Concrete tile CASING JOINTS: Glued X Clamped
1 Steel 3 RMP (SR) 6 Asbestos-Cement 9 Other (specify below) Welded
(2) PVC 4 ABS 7 Fiberglass Threaded
Blank casing diameter 5 in. to 40 ft., Dia in. to ft., Dia in. to ft.
Casing height above land surface 16 in., weight lbs./ft. Wall thickness or gauge No. SDR-26

TYPE OF SCREEN OR PERFORATION MATERIAL: (7) PVC 10 Asbestos-cement
1 Steel 3 Stainless steel 5 Fiberglass 8 RMP (SR) 11 Other (specify)
2 Brass 4 Galvanized steel 6 Concrete tile 9 ABS 12 None used (open hole)

SCREEN OR PERFORATION OPENINGS ARE: 5 Gauzed wrapped (8) Saw cut 11 None (open hole)
1 Continuous slot 3 Mill slot 6 Wire wrapped 9 Drilled holes
2 Louvered shutter 4 Key punched 7 Torch cut 10 Other (specify)

SCREEN-PERFORATED INTERVALS: From 40 ft. to 80 ft., From ft. to ft.
From ft. to ft., From ft. to ft.
GRAVEL PACK INTERVALS: From NONE ft. to ft., From ft. to ft.
From ft. to ft., From ft. to ft.

6 GROUT MATERIAL: (1) Neat cement 2 Cement grout 3 Bentonite 4 Other
Grout Intervals: From 3 ft. to 24 ft., From ft. to ft., From ft. to ft.

What is the nearest source of possible contamination:
1 Septic tank 4 Lateral lines 7 Pit privy 10 Livestock pens 14 Abandoned water well
2 Sewer lines 5 Cess pool (8) Sewage lagoon Proposed 11 Fuel storage 15 Oil well/Gas well
3 Watertight sewer lines 6 Seepage pit 9 Feedyard 12 Fertilizer storage 16 Other (specify below)
13 Insecticide storage
Direction from well? North West How many feet? 100

FROM	TO	LITHOLOGIC LOG
0	2	Top Soil
2	7	Shale Gray
7	9	Red Rock
9	13	Shale Green
13	16	Shale Gray
16	29	Lime Gray
29	30	Shale Gray
30	33	Lime Gray
33	40	Shale DK Gray
40	47.5	Lime Gray
47.5	48	Coal?
48	52	Lime Gray
52	59	Shale DK Gray
59	63	Lime Lite Gray
63	72	Shale Green

FROM	TO	PLUGGING INTERVALS
72	73	Lime Gray
73	78	Shale Gray
78	80	Lime Gray

7 CONTRACTOR'S OR LANDOWNER'S CERTIFICATION: This water well was (1) constructed, (2) reconstructed, or (3) plugged under my jurisdiction and was completed on (mo/day/year) Jun 1 90 and this record is true to the best of my knowledge and belief. Kansas Water Well Contractor's License No. 218 This Water Well Record was completed on (mo/day/yr) Jun 1 90 under the business name of Zinn Water Well Drlg by (signature) Joseph A. Zinn

INSTRUCTIONS: Use typewriter or ball point pen. *PLEASE PRESS FIRMLY* and *PRINT* clearly. Please fill in blanks, underline or circle the correct answers. Send top three copies to Kansas Department of Health and Environment, Bureau of Water, Topeka, Kansas 66620-7320. Telephone: 913-296-5545. Send one to WATER WELL OWNER and retain one for your records.

OFFICE USE ONLY T R E/W SEC. ¼ ¼ ¼