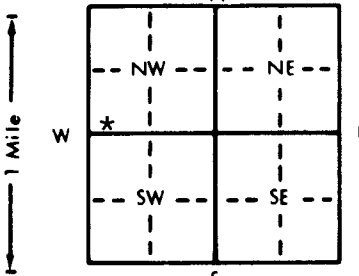


1 LOCATION OF WATER WELL:		Fraction	Section Number	Township Number	Range Number
County: Chase		SW 1/4 SW 1/4 NW 1/4	25	T 18 S	R 9 E/W
Distance and direction from nearest town or city street address of well if located within city? 2 1/2 North of Toledo, KS.					
2 WATER WELL OWNER: Rice Farms					
RR#, St. Address, Box #: Rt 5 Box 65			Board of Agriculture, Division of Water Resources		
City, State, ZIP Code: Emporia, KS. 66801			Application Number:		
3 LOCATE WELL'S LOCATION WITH AN "X" IN SECTION BOX:		4 DEPTH OF COMPLETED WELL: 82 ft. ELEVATION:			
		Depth(s) Groundwater Encountered 1. ft. 2. ft. 3. ft. WELL'S STATIC WATER LEVEL 58' ft. below land surface measured on mo/day/yr 12/2/94 Pump test data: Well water was ft. after hours pumping gpm Est. Yield 10-15 gpm: Well water was ft. after hours pumping gpm Bore Hole Diameter 8 in. to 82 ft. and in. to ft. WELL WATER TO BE USED AS: 5 Public water supply 8 Air conditioning 11 Injection well 1 Domestic 3 Feedlot 6 Oil field water supply 9 Dewatering 12 Other (Specify below) 2 Irrigation 4 Industrial 7 Lawn and garden only 10 Monitoring well Was a chemical/bacteriological sample submitted to Department? Yes No *; If yes, mo/day/yr sample was submitted Water Well Disinfected? Yes * No			
5 TYPE OF BLANK CASING USED:					
1 Steel		3 RMP (SR)	5 Wrought iron	8 Concrete tile	CASING JOINTS: Glued * Clamped
2 PVC		4 ABS	6 Asbestos-Cement	9 Other (specify below)	Welded
			7 Fiberglass		Threaded
Blank casing diameter 5 in. to 62 ft. Dia. in. to ft. Dia. in. to ft.					
Casing height above land surface 18 in., weight 200 lbs./ft. Wall thickness or gauge No.					
TYPE OF SCREEN OR PERFORATION MATERIAL:					
1 Steel		3 Stainless steel	5 Fiberglass	7 PVC	10 Asbestos-cement
2 Brass		4 Galvanized steel	6 Concrete tile	8 RMP (SR)	11 Other (specify)
				9 ABS	12 None used (open hole)
SCREEN OR PERFORATION OPENINGS ARE:					
1 Continuous slot		3 Mill slot	5 Gauzed wrapped	8 Saw cut	11 None (open hole)
2 Louvered shutter		4 Key punched	6 Wire wrapped	9 Drilled holes	
			7 Torch cut	10 Other (specify)	
SCREEN-PERFORATED INTERVALS: From 62 ft. to 82 ft. From ft. to ft.					
GRAVEL PACK INTERVALS: From 25 ft. to 82 ft. From ft. to ft.					
6 GROUT MATERIAL: 1 Neat cement 2 Cement grout 3 Bentonite 4 Other					
Grout Intervals: From 25 ft. to 25 ft. From ft. to ft. From ft. to ft.					
What is the nearest source of possible contamination:					
1 Septic tank		4 Lateral lines	7 Pit privy	10 Livestock pens	14 Abandoned water well
2 Sewer lines		5 Cess pool	8 Sewage lagoon	11 Fuel storage	15 Oil well/Gas well
3 Watertight sewer lines		6 Seepage pit	9 Feedyard	12 Fertilizer storage	16 Other (specify below)
				13 Insecticide storage	
Direction from well? East How many feet? 10					
FROM TO		LITHOLOGIC LOG	FROM TO	PLUGGING INTERVALS	
0	2	Topsoil			
2	5	Brown Clay			
5	7	Limestone			
7	8	Yellow Shale			
8	14	Limestone			
14	20	Gray Shale			
20	26	Yellow Shale & Limestone			
26	59	Gray Shale			
59	62	Yellow Shale & Limestone			
62	82	Gray Shale			
7 CONTRACTOR'S OR LANDOWNER'S CERTIFICATION: This water well was (1) constructed, (2) reconstructed, or (3) plugged under my jurisdiction and was completed on (mo/day/year) 12/2/94 and this record is true to the best of my knowledge and belief. Kansas Water Well Contractor's License No. 518 This Water Well Record was completed on (mo/day/yr) 12/6/94 under the business name of Blue Valley Drilling by (signature) [Signature]					
INSTRUCTIONS: Use typewriter or ball point pen. PLEASE PRESS FIRMLY and PRINT clearly. Please fill in blanks, underline or circle the correct answers. Send top three copies to Kansas Department of Health and Environment, Bureau of Water, Topeka, Kansas 66620-0001. Telephone: 913-296-5545. Send one to WATER WELL OWNER and retain one for your records.					