


1 LOCATION OF WATER WELL: County: Marion Fraction: MW 1/4 SW MW 1/4 Section Number: 35 Township Number: T 19 S Range Number: R 1 E

Distance and direction from nearest town or city street address of well if located within city?  
1 S Lehigh

2 WATER WELL OWNER: Boyce Saltzman  
 RR#, St. Address, Box #: Box 10  
 City, State, ZIP Code: Newton, KS. 67114  
 Board of Agriculture, Division of Water Resources  
 Application Number:

3 LOCATE WELL'S LOCATION WITH AN "X" IN SECTION BOX: 4 DEPTH OF COMPLETED WELL: 103 ft. ELEVATION:

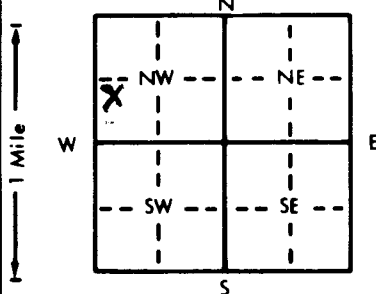

Depth(s) Groundwater Encountered 1. 12 ft. 2. 7 1/2 ft. 3. 103 ft.  
 WELL'S STATIC WATER LEVEL 12 ft. below land surface measured on mo/day/yr  
 Pump test data: Well water was 10 gpm. ft. after 9 hours pumping 103 gpm  
 Est. Yield 10 gpm. Well water was 20 ft. after 7 1/2 hours pumping 103 gpm  
 Bore Hole Diameter 9 in. to 20 ft., and 7 1/2 in. to 103 ft.  
 WELL WATER TO BE USED AS:  
 1 Domestic 2 Irrigation 3 Feedlot 4 Industrial 5 Public water supply 6 Oil field water supply 7 Lawn and garden only 8 Air conditioning 9 Dewatering 10 Monitoring well 11 Injection well 12 Other (Specify below)  
 Was a chemical/bacteriological sample submitted to Department? Yes No X; If yes, mo/day/yr sample was submitted  
 Water Well Disinfected? Yes Y No

5 TYPE OF BLANK CASING USED:  
 1 Steel 2 PVC 3 RMP (SR) 4 ABS 5 Wrought iron 6 Asbestos-Cement 7 Fiberglass 8 Concrete tile 9 Other (specify below) CASING JOINTS: Glued Y Clamped  
 Blank casing diameter 5 in. to 63 ft. Dia. in. to 12 ft. Dia. in. to 103 ft. Dia. in. to 214 ft.  
 Casing height above land surface 12 in., weight CLASS 160 lbs./ft. Wall thickness or gauge No. 214

TYPE OF SCREEN OR PERFORATION MATERIAL:  
 1 Steel 2 Brass 3 Stainless steel 4 Galvanized steel 5 Fiberglass 6 Concrete tile 7 PVC 8 RMP (SR) 9 ABS 10 Asbestos-cement 11 Other (specify) 12 None used (open hole)  
 SCREEN OR PERFORATION OPENINGS ARE:  
 1 Continuous slot 2 Louvered shutter 3 Mill slot 4 Key punched 5 Gauzed wrapped 6 Wire wrapped 7 Torch cut 8 Saw cut 9 Drilled holes 11 None (open hole)

SCREEN-PERFORATED INTERVALS: From 63 ft. to 103 ft. From 103 ft. to 103 ft. From 103 ft. to 103 ft.  
 GRAVEL PACK INTERVALS: From 63 ft. to 103 ft. From 103 ft. to 103 ft. From 103 ft. to 103 ft.

6 GROUT MATERIAL: 1 Neat cement 2 Cement grout 3 Bentonite 4 Other  
 Grout Intervals: From 0 ft. to 20 ft. From 20 ft. to 103 ft. From 103 ft. to 103 ft.

What is the nearest source of possible contamination:  
 1 Septic tank 2 Sewer lines 3 Watertight sewer lines 4 Lateral lines 5 Cess pool 6 Seepage pit 7 Pit privy 8 Sewage lagoon 9 Feedyard 10 Livestock pens 11 Fuel storage 12 Fertilizer storage 13 Insecticide storage 14 Abandoned water well 15 Oil well/Gas well 16 Other (specify below)  
 Direction from well? W How many feet? Will be 100+

FROM	TO	LITHOLOGIC LOG	FROM	TO	PLUGGING INTERVALS
0	14	Clay			
14	55	Blue + Gray Shale			
55	57	Broken Shale			
57	95	Blue "			
95	96	Water			
96	103	Gray Shale			

7 CONTRACTOR'S OR LANDOWNER'S CERTIFICATION: This water well was (1) constructed, (2) reconstructed, or (3) plugged under my jurisdiction and was completed on (mo/day/year) 11-21-95 and this record is true to the best of my knowledge and belief. Kansas Water Well Contractor's License No. 186 This Water Well Record was completed on (mo/day/yr) 12-4-95 under the business name of Backhus Drilling by (signature) Paul Backhus

INSTRUCTIONS: Use typewriter or ball point pen. PLEASE PRESS FIRMLY and PRINT clearly. Please fill in blanks, underline or circle the correct answers. Send top three copies to Kansas Department of Health and Environment, Bureau of Water, Topeka, Kansas 66620-0001. Telephone: 913-296-5545. Send one to WATER WELL OWNER and retain one for your records.