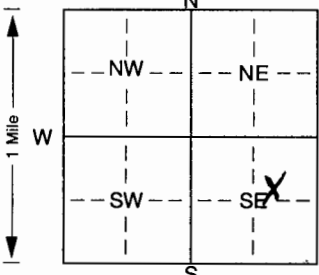


1] LOCATION OF WATER WELL: Fraction SW 1/4 NE 1/4 SE 1/4 Section Number 11 Township Number T 19 S Range Number R 1 E/W
 County: Morrison

Distance and direction from nearest town or city street address of well if located within city?
2 1/2 mi NE Lehigh

2] WATER WELL OWNER: Bon Duentgen
 RR#, St. Address, Box #: 203 S Vernon Board of Agriculture, Division of Water Resources
 City, State, ZIP Code: Lehigh, Ke. 67073 Application Number:

3] LOCATE WELL'S LOCATION WITH AN "X" IN SECTION BOX:

 4] DEPTH OF COMPLETED WELL: 75 ft. ELEVATION:
 Depth(s) Groundwater Encountered 1. 3.5 ft. 2. 6.5 ft. 3. 9.4-01 ft.
 WELL'S STATIC WATER LEVEL: 1.5 ft. below land surface measured on mo/day/yr 9-4-01
 Pump test data: Well water was 7 ft. after 7 hours pumping 7.5 gpm
 Est. Yield 1.5-2.0 gpm; Well water was 7 ft. after 7 hours pumping 7.5 gpm
 Bore Hole Diameter: 7 in. to 2.0 ft., and 7 in. to 7.5 ft.
 WELL WATER TO BE USED AS: 5 Public water supply 8 Air conditioning 11 Injection well
 1 Domestic 3 Feedlot 6 Oil field water supply 9 Dewatering 12 Other (Specify below)
 2 Irrigation 4 Industrial 7 Domestic (lawn & garden) 10 Monitoring well In. pasture & garden
 Was a chemical/bacteriological sample submitted to Department? Yes. X No. X; If yes, mo/day/yr sample was submitted
 Water Well Disinfected? Yes X No

5] TYPE OF BLANK CASING USED:
 1 Steel 3 RMP (SR) 5 Wrought iron 8 Concrete tile CASING JOINTS: Glued X Clamped
 2 PVC 4 ABS 6 Asbestos-Cement 9 Other (specify below) Welded
 7 Fiberglass Threaded
 Blank casing diameter 5 in. to 3.0 ft., Dia 12 in. to 2.14 ft., Dia 12 in. to 2.14 ft.
 Casing height above land surface 12 in., weight Class lbs./ft. Wall thickness or gauge No. 2.14
 TYPE OF SCREEN OR PERFORATION MATERIAL:
 1 Steel 3 Stainless steel 5 Fiberglass 7 PVC 10 Asbestos-cement
 2 Brass 4 Galvanized steel 6 Concrete tile 8 RMP (SR) 11 Other (specify)
 9 ABS 12 None used (open hole)
 SCREEN OR PERFORATION OPENINGS ARE:
 1 Continuous slot 3 Mill slot 5 Gauzed wrapped 8 Saw cut 11 None (open hole)
 2 Louvered shutter 4 Key punched 6 Wire wrapped 9 Drilled holes
 7 Torch cut 10 Other (specify) ft.
 SCREEN-PERFORATED INTERVALS: From 30 ft. to 75 ft., From ft. to ft.
 GRAVEL PACK INTERVALS: From ft. to ft., From ft. to ft.

6] GROUT MATERIAL: 1 Neat cement 2 Cement grout 3 Bentonite 4 Other
 Grout Intervals: From 0 ft. to 2.0 ft., From ft. to ft., From ft. to ft.
 What is the nearest source of possible contamination:
 1 Septic tank 4 Lateral lines 7 Pit privy 10 Livestock pens 14 Abandoned water well
 2 Sewer lines 5 Cess pool 8 Sewage lagoon 11 Fuel storage 15 Oil well/Gas well
 3 Watertight sewer lines 6 Seepage pit 9 Feedyard 12 Fertilizer storage 16 Other (specify below)
 13 Insecticide storage
 Direction from well? None within 1/4 mi. How many feet?

FROM	TO	LITHOLOGIC LOG	FROM	TO	PLUGGING INTERVALS
0	16	Yellow Clay + Shale			
16	35	Gray Shale			
35		Some Water			
35	65	Blue + Gray Shale			
65	66	Water			
66	75	Gray Shale			

7] CONTRACTOR'S OR LANDOWNER'S CERTIFICATION: This water well was (1) constructed, (2) reconstructed, or (3) plugged under my jurisdiction and was completed on (mo/day/year) 9-4-01 and this record is true to the best of my knowledge and belief. Kansas Water Well Contractor's Licence No. 180 This Water Well Record was completed on (mo/day/yr) 9-5-01 under the business name of Backhus Drilling by (signature) Paul Backhus