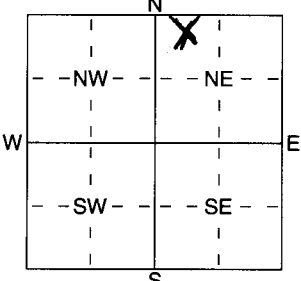


1 LOCATION OF WATER WELL: Fraction NW 1/4 NW 1/4 NE 1/4 Section Number 7 Township Number T 19 S Range Number R 1 E
 County: Morrison

Distance and direction from nearest town or city street address of well if located within city?
3 W 3 N Lehigh

2 WATER WELL OWNER: Paul Martin
 RR#, St. Address, Box #: 4667 Chateaw Ct Board of Agriculture, Division of Water Resources
 City, State, ZIP Code: San Diego Cal Application Number:

3 LOCATE WELL'S LOCATION WITH AN "X" IN SECTION BOX:

 4 DEPTH OF COMPLETED WELL 80 ft. ELEVATION:
 Depth(s) Groundwater Encountered 1 5.5 ft. 2 ft. 3 ft.
 WELL'S STATIC WATER LEVEL 15 ft. below land surface measured on mo/day/yr 12-20-09
 Pump test data: Well water was ft. after hours pumping gpm
 Est. Yield 2-3 gpm: Well water was ft. after hours pumping gpm
 WELL WATER TO BE USED AS: 5 Public water supply 8 Air conditioning 11 Injection well
 1 Domestic 3 Feedlot 6 Oil field water supply 9 Dewatering 12 Other (Specify below)
 2 Irrigation 4 Industrial 7 Domestic (lawn & garden) 10 Monitoring well
 Was a chemical/bacteriological sample submitted to Department? Yes No; If yes, mo/day/yr sample was submitted
 Water Well Disinfected? Yes No

5 TYPE OF BLANK CASING USED:
 1 Steel 3 RMP (SR) 5 Wrought iron 8 Concrete tile CASING JOINTS: Glued X Clamped
 2 PVC 4 ABS 6 Asbestos-Cement 9 Other (specify below) Welded
 7 Fiberglass Threaded
 Blank casing diameter 3 in. to 20 ft. Dia 5 in. to 60 ft. Dia in. to ft.
 Casing height above land surface 24 in., weight 160 lbs./ft. Wall thickness or gauge No. 219
 TYPE OF SCREEN OR PERFORATION MATERIAL:
 1 Steel 3 Stainless Steel 5 Fiberglass 7 PVC 10 Asbestos-Cement
 2 Brass 4 Galvanized Steel 6 Concrete tile 8 RMP (SR) 11 Other (Specify)
 9 ABS 12 None used (open hole)
 SCREEN OR PERFORATION OPENINGS ARE:
 1 Continuous slot 3 Mill slot 5 Gauzed wrapped 8 Saw cut 11 None (open hole)
 2 Louvered shutter 4 Key punched 6 Wire wrapped 9 Drilled holes
 7 Torch cut 10 Other (specify) ft.
 SCREEN-PERFORATED INTERVALS: From 20 ft. to 40 ft., From 60 ft. to 80 ft.
 GRAVEL PACK INTERVALS: From 20 ft. to 80 ft., From ft. to ft.

6 GROUT MATERIAL: 1 Neat cement 2 Cement grout 3 Bentonite 4 Other
 Grout Intervals: From 0 ft. to 20 ft., From ft. to ft., From ft. to ft.
 What is the nearest source of possible contamination:
 1 Septic tank 4 Lateral lines 7 Pit privy 10 Livestock pens 14 Abandoned water well
 2 Sewer lines 5 Cess pool 8 Sewage lagoon 11 Fuel storage 15 Oil well/Gas well
 3 Watertight sewer lines 6 Seepage pit 9 Feedyard 12 Fertilizer storage 16 Other (specify below)
 13 Insecticide storage
 Direction from well? SW How many feet? 100-200'

FROM	TO	LITHOLOGIC LOG	FROM	TO	PLUGGING INTERVALS
0	30	Clay			
30	40	Shale Little water			
40	55	Blue Shale			
55	57	Crumbled Shale Some water			
57	80	Blue & Gray Shale			

7 CONTRACTOR'S OR LANDOWNER'S CERTIFICATION: This water well was (1) constructed, (2) reconstructed, or (3) plugged under my jurisdiction and was completed on (mo/day/year) 12-20-09 and this record is true to the best of my knowledge and belief. Kansas Water Well Contractor's Licence No 180 This Water Well Record was completed on (mo/day/yr) 1-9-05 under the business name of Backhus Drilling by signature Paul Martin