


1 LOCATION OF WATER WELL: Fraction Ne 1/4 Ne 1/4 Se 1/4 Section Number 26 Township Number T 19 S Range Number R 1 E
 County: Marion

Distance and direction from nearest town or city street address of well if located within city?
1 E 1/2 S h. high

2 WATER WELL OWNER: Clark Weibe
 RR#, St. Address, Box #: RR 2 Board of Agriculture, Division of Water Resources
 City, State, ZIP Code: Hillsboro, Ks. 67063 Application Number:

3 LOCATE WELL'S LOCATION WITH AN "X" IN SECTION BOX:

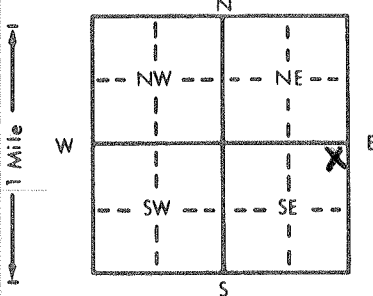

4 DEPTH OF COMPLETED WELL: 86 ft. ELEVATION: ft.

Depth(s) Groundwater Encountered 22 ft. 2. 72 ft. 3. ft.
 WELL'S STATIC WATER LEVEL 22 ft. below land surface measured on mo/day/yr 3-17-89

Pump test data: Well water was ft. after hours pumping gpm
 Est. Yield 10 gpm; Well water was ft. after hours pumping gpm
 Bore Hole Diameter 9 in. to 23 ft., and 7 1/2 in. to 26 ft.

WELL WATER TO BE USED AS: 5 Public water supply 8 Air conditioning 11 Injection well
 1 Domestic 3 Feedlot 6 Oil field water supply 9 Dewatering 12 Other (Specify below)
 2 Irrigation 4 Industrial 7 Lawn and garden only 10 Monitoring well

Was a chemical/bacteriological sample submitted to Department? Yes.....No X.....; If yes, mo/day/yr sample was submitted
 Water Well Disinfected? Yes X No

5 TYPE OF BLANK CASING USED: 5 Wrought iron 8 Concrete tile CASING JOINTS: Glued X Clamped
 1 Steel 3 RMP (SR) 6 Asbestos-Cement 9 Other (specify below) Welded
 2 PVC 4 ABS 7 Fiberglass Threaded

Blank casing diameter 5 in. to 65 ft., Dia in. to ft., Dia in. to ft.
 Casing height above land surface 24 in., weight Clas 92 160 lbs./ft. Wall thickness or gauge No. 2.14

TYPE OF SCREEN OR PERFORATION MATERIAL: 7 PVC 10 Asbestos-cement
 1 Steel 3 Stainless steel 5 Fiberglass 8 RMP (SR) 11 Other (specify)
 2 Brass 4 Galvanized steel 6 Concrete tile 9 ABS 12 None used (open hole)

SCREEN OR PERFORATION OPENINGS ARE: 5 Gauzed wrapped 8 Saw cut 11 None (open hole)
 1 Continuous slot 3 Mill slot 6 Wire wrapped 9 Drilled holes
 2 Louvered shutter 4 Key punched 7 Torch cut 10 Other (specify)

SCREEN-PERFORATED INTERVALS: From 65 ft. to 26 ft., From ft. to ft.
 From ft. to ft., From ft. to ft.

GRAVEL PACK INTERVALS: From 20 ft. to 26 ft., From ft. to ft.
 From ft. to ft., From ft. to ft.

6 GROUT MATERIAL: 1 Neat cement 2 Cement grout 3 Bentonite 4 Other
 Grout Intervals: From 0 ft. to 20 ft., From ft. to ft., From ft. to ft.

What is the nearest source of possible contamination: 10 Livestock pens 14 Abandoned water well
 1 Septic tank 4 Lateral lines 7 Pit privy 11 Fuel storage 15 Oil well/Gas well
 2 Sewer lines 5 Cess pool 8 Sewage lagoon 12 Fertilizer storage 16 Other (specify below)
 3 Watertight sewer lines 6 Seepage pit 9 Feedyard 13 Insecticide storage

Direction from well? In Pasture for Cattle How many feet?

FROM TO LITHOLOGIC LOG FROM TO PLUGGING INTERVALS

FROM	TO	LITHOLOGIC LOG	FROM	TO	PLUGGING INTERVALS
0	26	Yellow Clay & mixed loose lime			
26	68	Blue Shale			
68	72	Crumbled Shale & Water			
72	86	Blue Shale			

7 CONTRACTOR'S OR LANDOWNER'S CERTIFICATION: This water well was (1) constructed (2) reconstructed, or (3) plugged under my jurisdiction and was completed on (mo/day/year) 3-17-89 and this record is true to the best of my knowledge and belief. Kansas Water Well Contractor's License No. 180 This Water Well Record was completed on (mo/day/yr) 3-22-89 under the business name of Backhus Drilling by (signature) Paul H. Backhus