


1 LOCATION OF WATER WELL: Fraction SE 1/4 NE 1/4 NE 1/4 Section Number 27 Township Number T 19 S Range Number R 1 E EW
 County: Marion

Distance and direction from nearest town or city street address of well if located within city?
1/8 mile South of Lehigh

2 WATER WELL OWNER: Twila Talley Rt. #1
 RR#, St. Address, Box # : Rt. #1
 City, State, ZIP Code : Lehigh, Kansas 67073
 Board of Agriculture, Division of Water Resources
 Application Number:

3 LOCATE WELL'S LOCATION WITH AN "X" IN SECTION BOX:

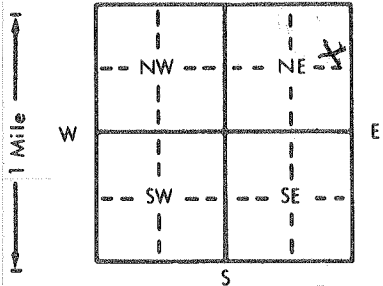

4 DEPTH OF COMPLETED WELL: 81' ft. ELEVATION: Slope
 Depth(s) Groundwater Encountered 1. 30' ft. 2. 70' ft. 3. ft.
 WELL'S STATIC WATER LEVEL .. 15' ft. below land surface measured on mo/day/yr ... 5-15-89
 Pump test data: Well water was 20 ft. after 1 hours pumping ... 20 gpm
 Est. Yield 20 gpm: Well water was ft. after hours pumping gpm
 Bore Hole Diameter. ... 9 in. to ... 8 1/2 in. to ... in. to ft.
 WELL WATER TO BE USED AS: 5 Public water supply 8 Air conditioning 11 Injection well
 1 Domestic 3 Feedlot 6 Oil field water supply 9 Dewatering 12 Other (Specify below)
 2 Irrigation 4 Industrial Lawn and garden only 10 Monitoring well
 Was a chemical/bacteriological sample submitted to Department? Yes.....No.. : If yes, mo/day/yr sample was submitted
 Water Well Disinfected? Yes No

5 TYPE OF BLANK CASING USED:
 1 Steel 3 RMP (SR) 5 Wrought iron 8 Concrete tile CASING JOINTS: Glued Clamped
 PVC 4 ABS 6 Asbestos-Cement 9 Other (specify below) Welded
 7 Fiberglass Threaded
 Blank casing diameter .. 5 1/2 in. to ... 8 1/2 in. to ... ft., Dia ... in. to ... ft., Dia ... in. to ... ft.
 Casing height above land surface. ... 30 in., weight ... 2.29 lbs./ft. Wall thickness or gauge No. ... 214
 TYPE OF SCREEN OR PERFORATION MATERIAL:
 PVC 10 Asbestos-cement
 1 Steel 3 Stainless steel 5 Fiberglass 8 RMP (SR) 11 Other (specify)
 2 Brass 4 Galvanized steel 6 Concrete tile 9 ABS 12 None used (open hole)
 SCREEN OR PERFORATION OPENINGS ARE:
 5 Gauzed wrapped Saw cut 11 None (open hole)
 1 Continuous slot 3 Mill slot 6 Wire wrapped 9 Drilled holes
 2 Louvered shutter 4 Key punched 7 Torch cut 10 Other (specify)
 SCREEN-PERFORATED INTERVALS: From ... 20 ft. to ... 40 ft., From ... ft. to ... ft.
 From ... 60 ft. to ... 80 ft., From ... ft. to ... ft.
 GRAVEL PACK INTERVALS: From ... 10 ft. to ... 50 ft., From ... 55 ft. to ... 81 ft.
 From ... ft. to ... ft., From ... ft. to ... ft.

6 GROUT MATERIAL: Neat cement 2 Cement grout 3 Bentonite 4 Other
 Grout Intervals: From ... 0 ft. to ... 10 ft., From ... 50 ft. to ... 55 ft., From ... ft. to ... ft.
 What is the nearest source of possible contamination:
 Livestock pens 14 Abandoned water well
 1 Septic tank 4 Lateral lines 7 Pit privy 11 Fuel storage 15 Oil well/Gas well
 2 Sewer lines 5 Cess pool 8 Sewage lagoon 12 Fertilizer storage 16 Other (specify below)
 3 Watertight sewer lines 6 Seepage pit 9 Feedyard 13 Insecticide storage
 Direction from well? East How many feet? 250' to East

FROM	TO	LITHOLOGIC LOG	FROM	TO	PLUGGING INTERVALS
0	14	Clay			
14	16	Red Clay			
16	40	Shale			
40	42	Limestone Rock			
42	81	Shale			

7 CONTRACTOR'S OR LANDOWNER'S CERTIFICATION: This water well was constructed, (2) reconstructed, or (3) plugged under my jurisdiction and was completed on (mo/day/year) ... 5/15/89 ... and this record is true to the best of my knowledge and belief. Kansas Water Well Contractor's License No. ... 362 ... This Water Well Record was completed on (mo/day/yr) ... 5-17-89 ... under the business name of Martin Supply by (signature) Bruce Salmond

INSTRUCTIONS: Use typewriter or ball point pen. PLEASE PRESS FIRMLY and PRINT clearly. Please fill in blanks, underline or circle the correct answers. Send top three copies to Kansas Department of Health and Environment, Bureau of Water Protection, Topeka, Kansas 66620-7320. Telephone: 913-296-5514. Send one to WATER WELL OWNER and retain one for your records.