

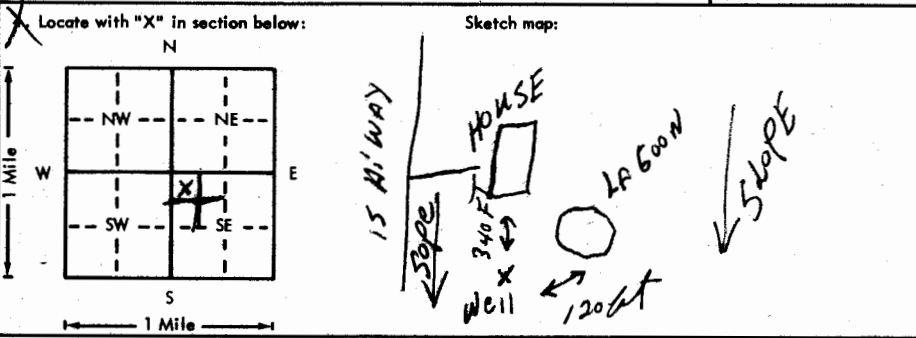
USE TYPEWRITER OR BALL POINT PEN-PRESS FIRMLY, PRINT CLEARLY.

WRONG WATER WELL RECORD KSA 82a-1201-1215

Kansas Department of Health and Environment-Division of Environment (Water well Contractors) Topeka, Kansas 66620

1. Location of well: County **MARION** Fraction **NW 1/4 SE 1/4** Section number **33** Township number **T 19 S R 1 E** Range number **1**

2. Distance and direction from nearest town or city: **2 W 1/2 S** Street address of well location if in city: **OF LEHIGH ONIS** 3. Owner of well: **LARRY SCHMIDT** R.R. or street: **RFD 1 Box 69** City, state, zip code: **LEHIGH KANS 67073**

4. Locate with "X" in section below: Sketch map: 

5. Type and color of material

	From	To
<i>top soil</i>	0	1
<i>Red Clay</i>	1	10
<i>Shale Black</i>	10	62
<i>Limestone</i>	62	67
<i>Shale Black</i>	67	85

6. Bore hole dia. **10** in. Completion date **8-1-76** Well depth **85** ft.

7. Cable tool Rotary Driven Dug Hollow rod Jetted Bored Reverse rotary

8. Use: Domestic Public supply Industry Irrigation Air conditioning Stock Lawn Oil field water Other

9. Casing: Material **PIT** Height: **Above** or below Threading: Threaded Welded Surface **18** in. RMP PVC Weight **1.50** lbs./ft. Dia. **5** in. to **85** ft. depth Wall Thickness: inches or Dia. in. to ft. depth gage No. **200**

10. Screens: Manufacturer's name **J & J** Type **RMP** Dia. **5** Slot/gauze **.06** Length **40** ft. Set between **45** ft. and **85** ft. Gravel pack? **yes** Size range of material **1/4-1/2**

11. Static water level: **20** ft. below land surface Date **8-1-76** mo./day/yr.

12. Pumping level below land surfaces: **65** ft. after **2** hrs. pumping **6** g.p.m. **6-8** g.p.m. Estimated maximum yield **6-8** g.p.m.

13. Water sample submitted: Yes No Date **7-28-76** mo./day/yr.

14. Well head completion: Pitless adapter **18** inches above grade

15. Well grouted? With: Neat cement Bentonite Concrete Depth: From **7** ft. to **14** ft.

16. Nearest source of possible contamination: **120** ft. Direction **E** Type **Lagoon** Well disinfected upon completion? Yes No

17. Pump: Not installed Manufacturer's name **Red Jacket** Model number **QVC** HP **1/2** Volts **230** Length of drop pipe **70** ft. capacity **10** g.p.m. Type: Submersible Turbine Jet Reciprocating Centrifugal Other

18. Elevation: 19. Remarks: (Use a second sheet if needed)

20. Water well contractor's certification: This well was drilled under my jurisdiction and this report is true to the best of my knowledge and belief. **DHR Well Service** Business name **428 W. 3rd Newton Kan** License No. **211** Address **W. Williams** Signed **W. Williams** Date **9-6-76** Authorized representative

Forward the white, blue and pink copies to the Department of Health and Environment

Form WWC-5

19 1-10 33 WWC-5