



	Property Boundary		Monitoring Well		Gas		Commercial Property
	Product Lines		Soil Boring		Overhead Electric		Residential Property
	Pump Island		Geotech Soil Boring		Telecom		Vacant Property
	AST Battery				Water		


Notes:
 1) No basements observed within 500-ft of release area
 2) Unlabeled property is City of Lehigh right-of-way

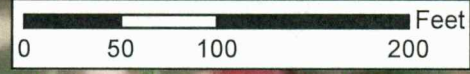

DESIGNED BY:	CC
DRAWN BY:	CC
CHECKED BY:	RW
APPROVED BY:	CC
DATE:	JUNE 2019

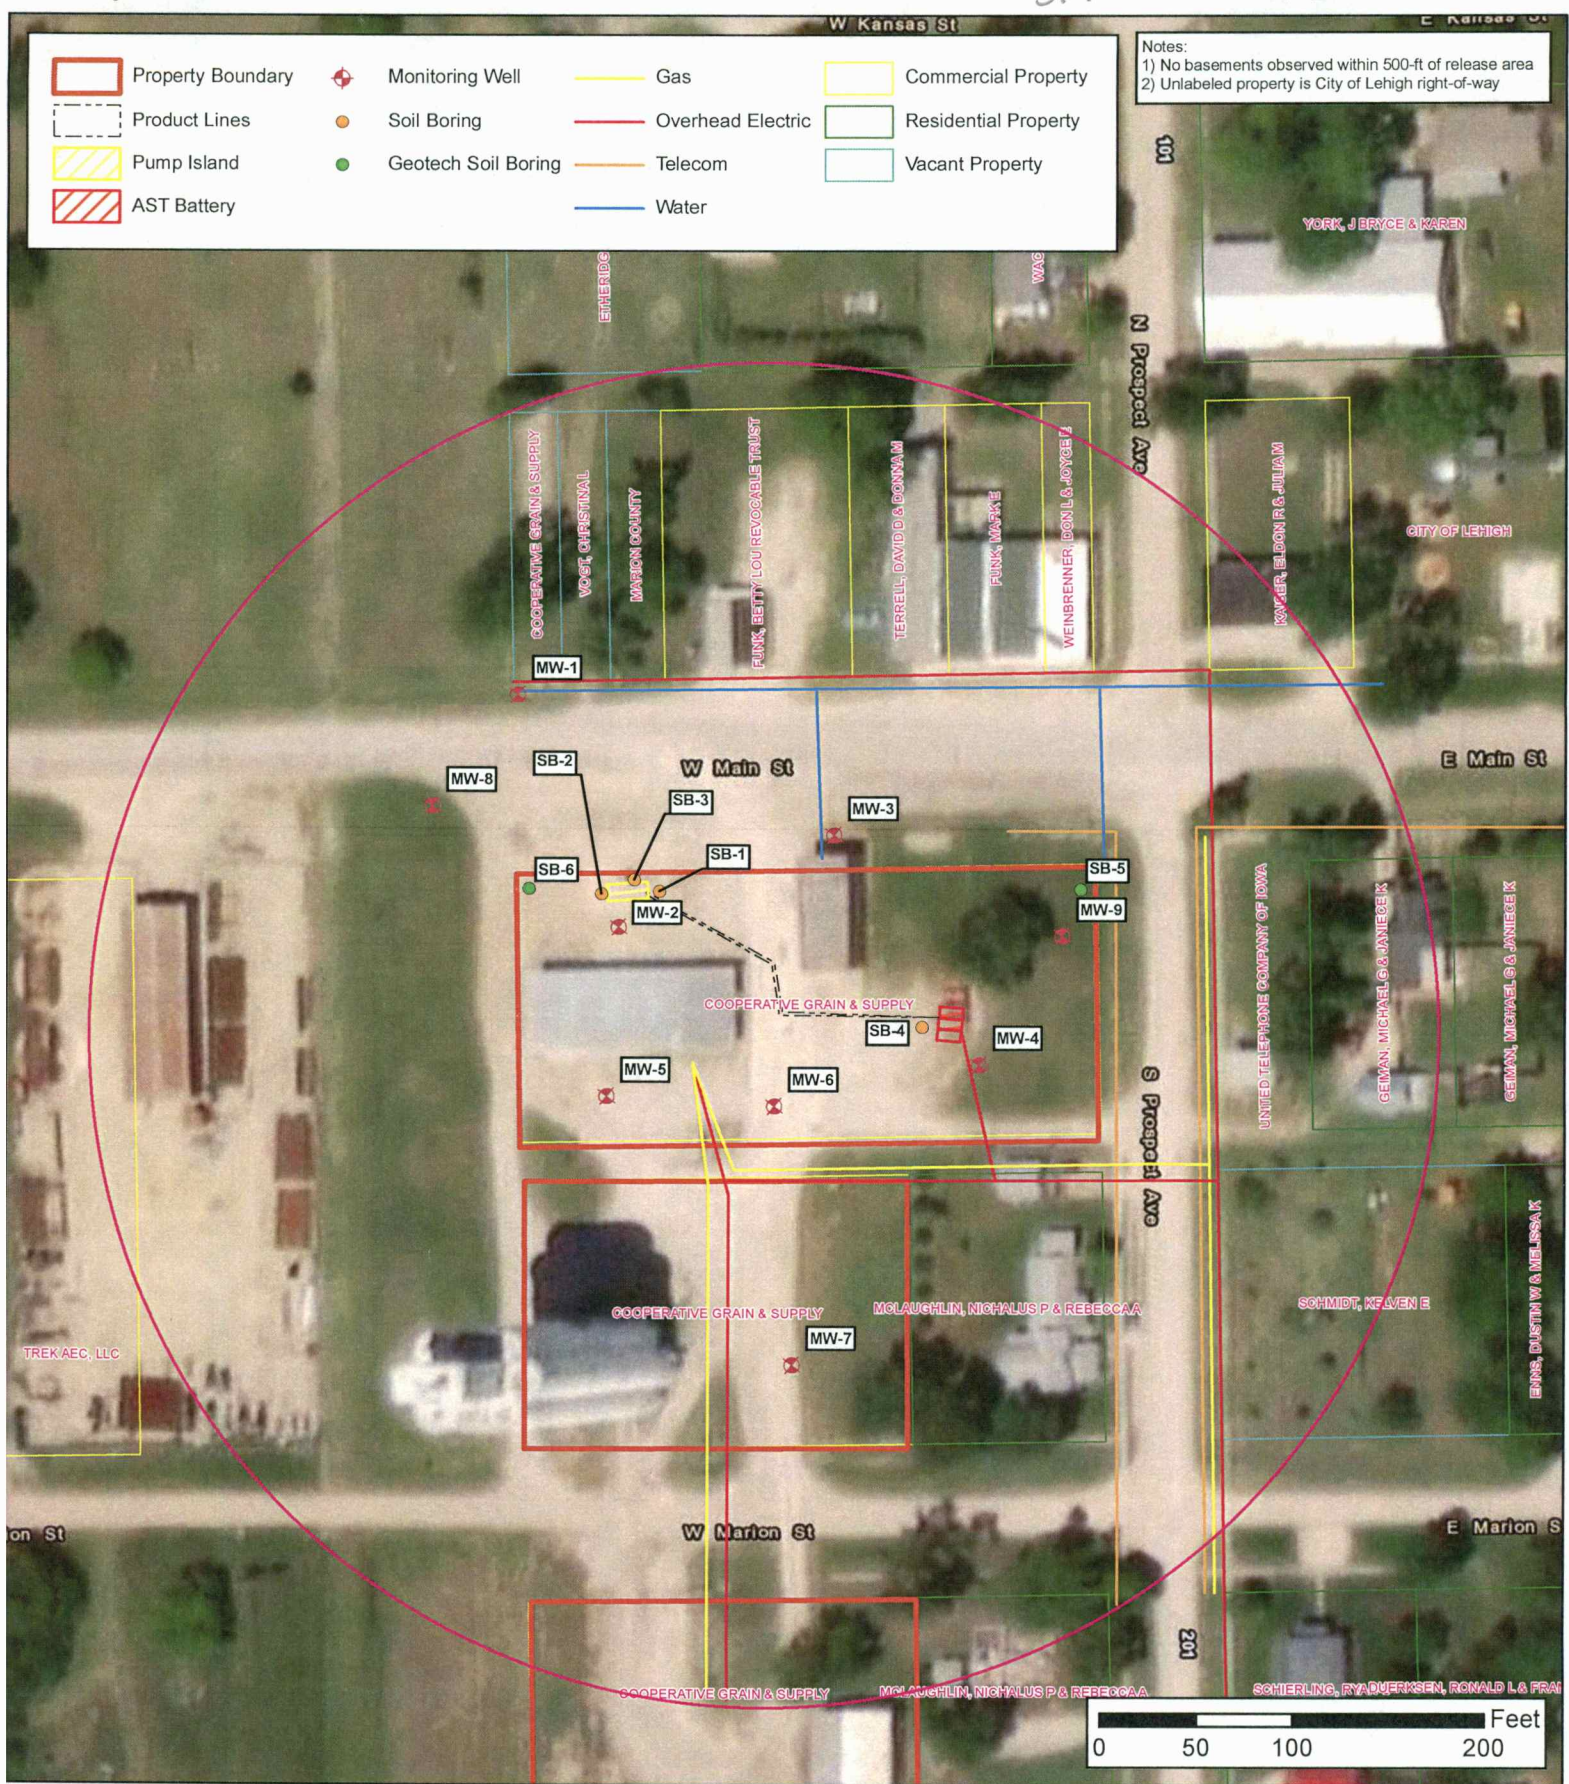

Area Base Map (350-ft radius)
Cooperative Grain and Supply Co.



A5-057-40489
 113 W. Main Street
 Lehigh, KS

FIGURE
2.1

LSA Report