

LOCATION OF WATER WELL: Fraction SE 1/4 NW 1/4 SW 1/4 Section Number 2 Township Number T 19 S Range Number R 10 E  
 County: Lyon Distance and direction from nearest town or city? 3 W 1/2 N Emporia Street address of well if located within city?

WATER WELL OWNER: Ed Grossenbacher  
 IR#, St. Address, Box #: 31550 Commercial Board of Agriculture, Division of Water Resources  
 City, State, ZIP Code: Emporia KS 66801 Application Number: NA


DEPTH OF COMPLETED WELL: 65 ft. Bore Hole Diameter: 12 in. to 65 ft., and \_\_\_\_\_ in. to \_\_\_\_\_ ft.  
 Well Water to be used as:  
 Domestic  Feedlot  Oil field water supply  Air conditioning  Injection well  
 Irrigation  Industrial  Lawn and garden only  Dewatering  Other (Specify below)  
 Observation well  
 Well's static water level: 11 ft. below land surface measured on \_\_\_\_\_ month 9 day 82 year  
 Pump Test Data: Well water was \_\_\_\_\_ ft. after \_\_\_\_\_ hours pumping \_\_\_\_\_ gpm  
 Est. Yield: 3 gpm: Well water was \_\_\_\_\_ ft. after \_\_\_\_\_ hours pumping \_\_\_\_\_ gpm

TYPE OF BLANK CASING USED:  
 Steel  RMP (SR)  Asbestos-Cement  Concrete tile  Other (specify below)  
 PVC  ABS  Fiberglass  
 Blank casing dia: 8 in. to 11 ft., Dia: 10 in. to 12 ft., Dia: \_\_\_\_\_ in. to \_\_\_\_\_ ft.  
 Casing height above land surface: 24 in., weight \_\_\_\_\_ lbs./ft. Wall thickness or gauge No: 3/8

TYPE OF SCREEN OR PERFORATION MATERIAL:  
 Steel  Stainless steel  Fiberglass  PVC  Asbestos-cement  
 Brass  Galvanized steel  Concrete tile  ABS  Other (specify) \_\_\_\_\_  
 None used (open hole)  
 Screen or Perforation Openings Are:  
 Continuous slot  Mill slot  Gauzed wrapped  Saw cut  None (open hole)  
 Louvered shutter  Key punched  Wire wrapped  Drilled holes 3/8  
 Torch cut  Other (specify) \_\_\_\_\_  
 Screen-Perforation Dia: 10 in. to 65 ft., Dia: \_\_\_\_\_ in. to \_\_\_\_\_ ft.  
 Screen-Perforated Intervals: From 12 ft. to 50 ft., From 50 ft. to 65 ft. to Bottom  
 Gravel Pack Intervals: From None ft. to \_\_\_\_\_ ft., From \_\_\_\_\_ ft. to \_\_\_\_\_ ft.

GROUT MATERIAL:  Neat cement  Cement grout  Bentonite  Other \_\_\_\_\_  
 Grouted Intervals: From 11 ft. to 0 ft., From \_\_\_\_\_ ft. to \_\_\_\_\_ ft.  
 What is the nearest source of possible contamination:  
 Septic tank  Cess pool  Sewage lagoon  Fuel storage  Abandoned water well  
 Sewer lines  Seepage pit  Feed yard  Fertilizer storage  Oil well/Gas well  
 Lateral lines  Pit privy  Livestock pens  Insecticide storage  Other (specify below)  
 Watertight sewer lines  
 Direction from well: N How many feet: 55 ? Water Well Disinfected? Yes  No  
 Was a chemical/bacteriological sample submitted to Department? Yes \_\_\_\_\_ No  If yes, date sample was submitted \_\_\_\_\_ month \_\_\_\_\_ day \_\_\_\_\_ year: Pump Installed? Yes \_\_\_\_\_ No  
 If Yes: Pump Manufacturer's name \_\_\_\_\_ Model No. \_\_\_\_\_ HP \_\_\_\_\_ Volts \_\_\_\_\_  
 Depth of Pump Intake \_\_\_\_\_ ft. Pumps Capacity rated at \_\_\_\_\_ gal./min.  
 Type of pump:  Submersible  Turbine  Jet  Centrifugal  Reciprocating  Other

CONTRACTOR'S OR LANDOWNER'S CERTIFICATION: This water well was  constructed,  reconstructed, or  plugged under my jurisdiction and was completed on \_\_\_\_\_ month \_\_\_\_\_ day \_\_\_\_\_ year  
 and this record is true to the best of my knowledge and belief. Kansas Water Well Contractor's License No. 20382  
 This Water Well Record was completed on \_\_\_\_\_ month \_\_\_\_\_ day \_\_\_\_\_ year under the business name of McNee Drilling & Metals by (signature) [Signature]

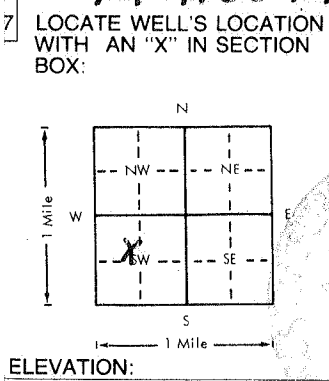

FROM	TO	LITHOLOGIC LOG	FROM	TO	LITHOLOGIC LOG
0	1	Cl Red	42	50	Sh Variegated
1	3	Cl W Gravel	50	52	Brn Lined Chert
3	8	Sh Blue	52	65	Shale Calc.
8	17	Shak lime sand	65TD		All Depth + 5'
17	27	Weakly cemented sand & sandstone			For Ground Level calculation.
27	29	Lime Gray Hard			
29	31	sh gray			
31	36	sh blue calc			
36	42	Red & green sh sand			

Depth(s) Groundwater Encountered: 1. 17 ft. 2. \_\_\_\_\_ ft. 3. \_\_\_\_\_ ft. 4. \_\_\_\_\_ ft. (Use a second sheet if needed)  
 INSTRUCTIONS: Use typewriter or ball point pen, please press firmly and PRINT clearly. Please fill in blanks, underline or circle the correct answers. Send top three copies to Kansas Department of Health and Environment, Division of Environment, Water Well Contractors, Topeka, KS 66620. Send one to WATER WELL OWNER and retain one for your records.