


LOCATION OF WATER WELL: County: **LYON** Fraction: **SE 1/4 SE 1/4 SE 1/4** Section Number: **5** Township Number: **T 19 S** Range Number: **R 10 W**

Distance and direction from nearest town or city street address of well if located within city?
FROM CITY OF EMPORIA - 5 M W AND 1 M N OF HWY 50 ON IE OF PLYMOUTH

WATER WELL OWNER: **HARRY HANSON**
 RR#, St. Address, Box # **RTS BOX 176-13 - EMPORIA KS - 66801**
 City, State, ZIP Code
 Board of Agriculture, Division of Water Resources
 Application Number: **-**

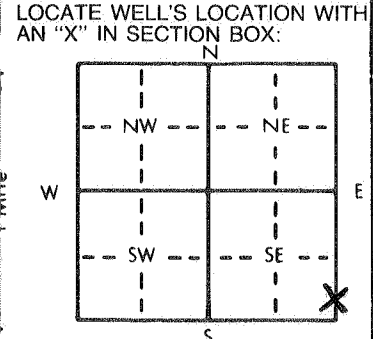

4 DEPTH OF COMPLETED WELL: **18** ft. ELEVATION: **-**
 Depth(s) Groundwater Encountered 1. **UNKNOWN** ft. 2. **-** ft. 3. **-** ft.
 WELL'S STATIC WATER LEVEL: **8** ft. below land surface measured on mo/day/yr **11-06-90**
 Pump test data: Well water was **-** ft. after **-** hours pumping **-** gpm
 Est. Yield **1.5** gpm: Well water was **-** ft. after **-** hours pumping **-** gpm
 Bore Hole Diameter: **4 7/8 to 1 1/2** ft., and **1 1/2** in. to **-** in.
 WELL WATER TO BE USED AS: **NA** 5 Public water supply 8 Air conditioning 11 Injection well
 1 Domestic 3 Feedlot 6 Oil field water supply 9 Dewatering 12 Other (Specify below)
 2 Irrigation 4 Industrial 7 Lawn and garden only 10 Monitoring well
 Was a chemical/bacteriological sample submitted to Department? Yes **-** No **X**; If yes, mo/day/yr sample was submitted **-**
 Water Well Disinfected? Yes **X** No **-**

TYPE OF BLANK CASING USED:
 1 Steel 3 RMP (SR) 5 Wrought iron 8 Concrete tile CASING JOINTS: Glued **-** Clamped **-**
 2 PVC 4 ABS 6 Asbestos-Cement 9 Other (specify below) Welded **-**
 7 Fiberglass **LIMESTONE** Threaded **-**

Blank casing diameter: **4 7/8 to 1 1/2** ft., Dia **-** in. to **-** in. Dia **-** in. to **-** in. to **-** ft.
 Casing height above land surface: **60** in., weight **-** lbs./ft. Wall thickness or gauge No. **-**

TYPE OF SCREEN OR PERFORATION MATERIAL: **NA** 7 PVC 10 Asbestos-cement
 1 Steel 3 Stainless steel 5 Fiberglass 8 RMP (SR) 11 Other (specify) **-**
 2 Brass 4 Galvanized steel 6 Concrete tile 9 ABS 12 None used (open hole)


SCREEN OR PERFORATION OPENINGS ARE: **NA** 5 Gauzed wrapped 8 Saw cut 11 None (open hole)
 1 Continuous slot 3 Mill slot 6 Wire wrapped 9 Drilled holes
 2 Louvered shutter 4 Key punched 7 Torch cut 10 Other (specify) **-**

SCREEN-PERFORATED INTERVALS: From **NA** ft. to **-** ft., From **-** ft. to **-** ft.
 From **-** ft. to **-** ft., From **-** ft. to **-** ft.
 GRAVEL PACK INTERVALS: From **NA** ft. to **-** ft., From **-** ft. to **-** ft.
 From **-** ft. to **-** ft., From **-** ft. to **-** ft.

GROUT MATERIAL: * 1 Neat cement 2 Cement grout 3 Bentonite 4 Other **CLAY**
 Grout Intervals: From **+ 2** ft. to **- 5** ft., From **-** ft. to **-** ft., From **-** ft. to **-** ft.

What is the nearest source of possible contamination:
 1 Septic tank 4 Lateral lines 7 Pit privy 10 Livestock pens 14 Abandoned water well
 2 Sewer lines 5 Cess pool 8 Sewage lagoon 11 Fuel storage 15 Oil well/Gas well
 3 Watertight sewer lines 6 Seepage pit 9 Feedyard 12 Fertilizer storage 16 Other (specify below)
 13 Insecticide storage

Direction from well? **SW** How many feet? **25**

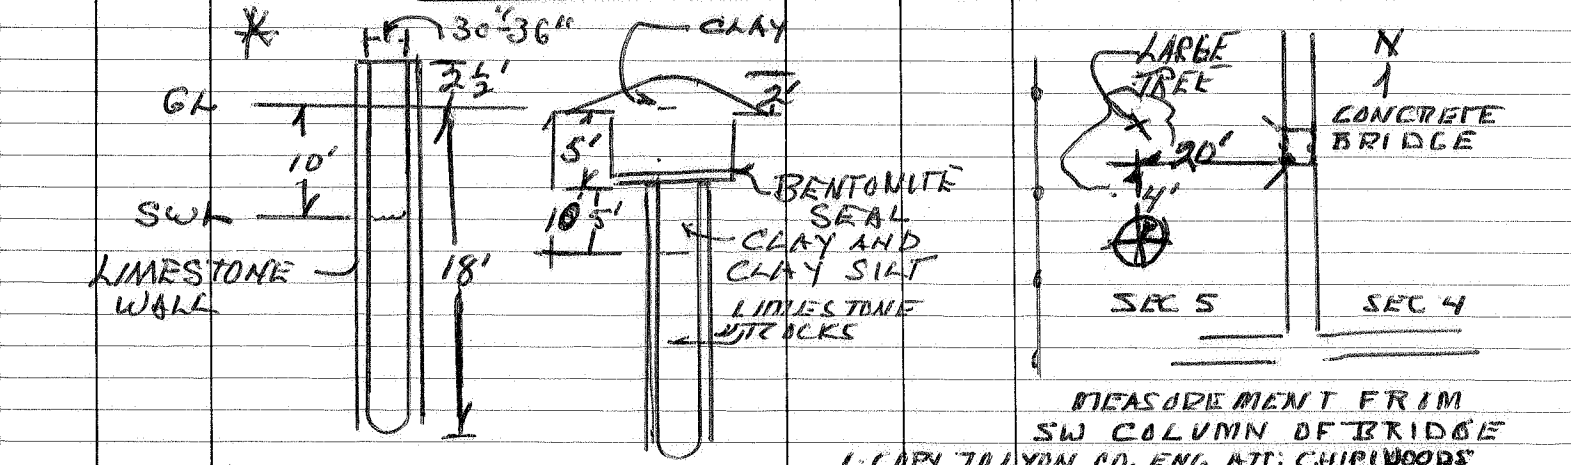

CONTRACTOR'S OR LANDOWNER'S CERTIFICATION: This water well was (1) constructed, (2) reconstructed, or (3) plugged under my jurisdiction and was completed on (mo/day/year) **11-06-90** and this record is true to the best of my knowledge and belief. Kansas Water Well Contractor's License No. **479** This Water Well Record was completed on (mo/day/yr) **11-07-90** under the business name of **EBBERTS DRILLING** by (signature) **Gregory Ebbert**