


1 LOCATION OF WATER WELL: Fraction SE 1/4 SE 1/4 NW 1/4 Section Number 8 Township Number T 19 S Range Number R 10 EW
 County: LYON

Distance and direction from nearest town or city street address of well if located within city?
NE COR. BIK 6 - PLYMOUTH - APPROX 5 M - W OF EMPORIA

2 WATER WELL OWNER: WARREN DRUMMOND ESTATE - MAURICE COPT
 RR#, St. Address, Box #: 1201 MAGIC CIRCLE Board of Agriculture, Division of Water Resources
 City, State, ZIP Code: EMPORIA KS 66801 Application Number:

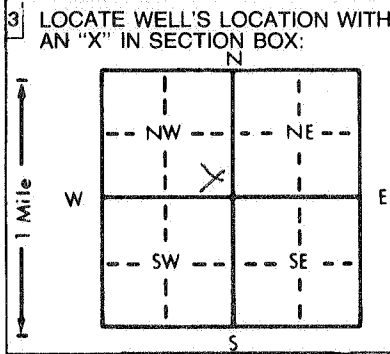

4 DEPTH OF COMPLETED WELL: 48 ft. ELEVATION: _____
 Depth(s) Groundwater Encountered: 1. UNKNOWN ft. 2. _____ ft. 3. _____ ft.
 WELL'S STATIC WATER LEVEL: 24 ft. below land surface measured on mo/day/yr 07-13-92
 Pump test data: Well water was _____ ft. after 1/2 hours pumping 12 gpm
 Est. Yield 5 gpm: Well water was _____ ft. after _____ hours pumping _____ gpm
 Bore Hole Diameter: ? in. to TD ft., and _____ in. to _____ ft.
 WELL WATER TO BE USED AS: 5 Public water supply 8 Air conditioning 11 Injection well
 1 Domestic 3 Feedlot 6 Oil field water supply 9 Dewatering 12 Other (Specify below)
 2 Irrigation 4 Industrial 7 Lawn and garden only 10 Monitoring well _____
 Was a chemical/bacteriological sample submitted to Department? Yes _____ No X; If yes, mo/day/yr sample was submitted _____
 Water Well Disinfected? Yes X No _____


5 TYPE OF BLANK CASING USED: 5 Wrought iron 8 Concrete tile CASING JOINTS: Glued _____ Clamped _____
 1 Steel 3 RMP (SR) 6 Asbestos-Cement 9 Other (specify below) Welded _____
 2 PVC 4 ABS 7 Fiberglass _____ Threaded X
 Blank casing diameter: 4 in. to 48 ft., Dia _____ in. to _____ ft., Dia _____ in. to _____ ft.
 Casing height above land surface: _____ in., weight _____ lbs./ft. Wall thickness or gauge No. _____

TYPE OF SCREEN OR PERFORATION MATERIAL: 7 PVC 10 Asbestos-cement
 1 Steel 3 Stainless steel 5 Fiberglass 8 RMP (SR) 11 Other (specify) _____
 2 Brass 4 Galvanized steel 6 Concrete tile 9 ABS 12 None used (open hole)

SCREEN OR PERFORATION OPENINGS ARE: 5 Gauzed wrapped 8 Saw cut 11 None (open hole)
 1 Continuous slot 3 Mill slot 6 Wire wrapped 9 Drilled holes
 2 Louvered shutter 4 Key punched 7 Torch cut 10 Other (specify) _____

SCREEN-PERFORATED INTERVALS: From 30 ft. to 40 ft., From 45 ft. to 48 ft.
 From _____ ft. to _____ ft., From _____ ft. to _____ ft.
 GRAVEL PACK INTERVALS: From NA + UNKNOWN ft., From _____ ft. to _____ ft.
 From _____ ft. to _____ ft., From _____ ft. to _____ ft.

6 GROUT MATERIAL: 1 Neat cement 2 Cement grout 3 Bentonite 4 Other _____
 Grout Intervals: From 2 - ABOVE CONCRETE SLAB ft., From _____ ft. to _____ ft., From _____ ft. to _____ ft.
 What is the nearest source of possible contamination:
 1 Septic tank 4 Lateral lines 7 Pit privy 10 Livestock pens 14 Abandoned water well
 2 Sewer lines 5 Cess pool 8 Sewage lagoon 11 Fuel storage 15 Oil well/Gas well
 3 Watertight sewer lines 6 Seepage pit 9 Feedyard 12 Fertilizer storage 16 Other (specify below)
 13 Insecticide storage HAND DUG

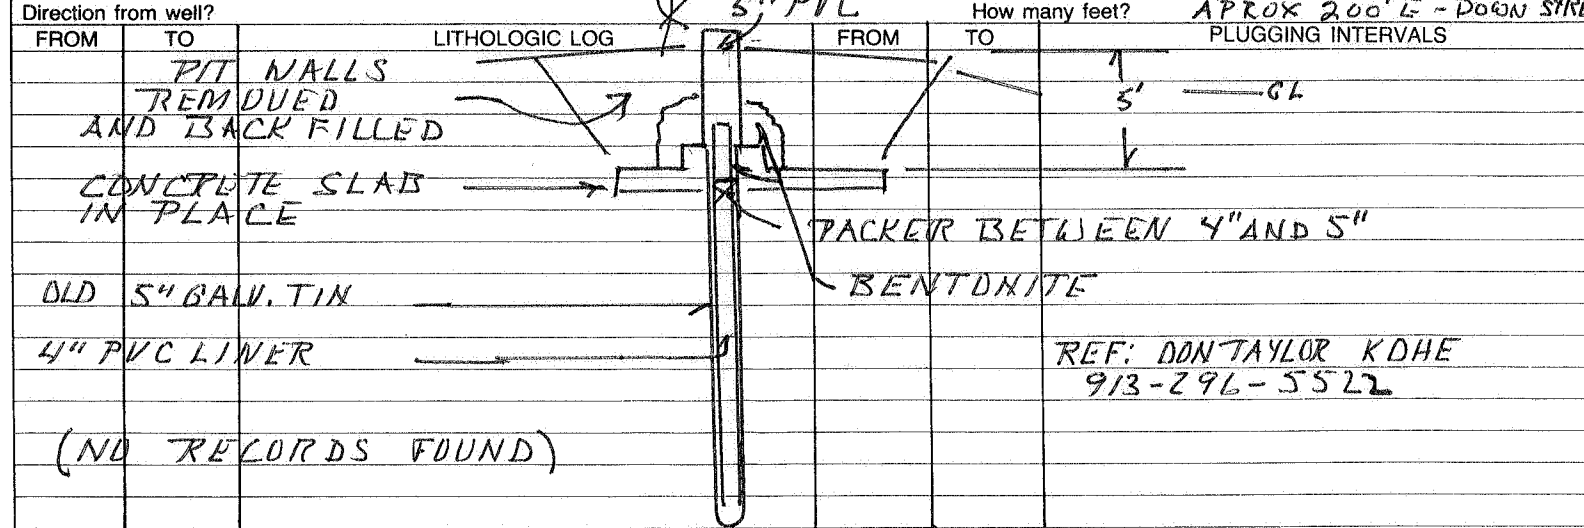

7 CONTRACTOR'S OR LANDOWNER'S CERTIFICATION: This water well was (1) constructed, (2) reconstructed, or (3) plugged under my jurisdiction and was completed on (mo/day/year) 07-15-92 and this record is true to the best of my knowledge and belief. Kansas Water Well Contractor's License No. 479 This Water Well Record was completed on (mo/day/yr) 07-16-92 under the business name of EBBERTS DRILLING by (signature) Morgan Yellow