


1 LOCATION OF WATER WELL: Fraction SE 1/4 SE 1/4 NW 1/4 Section Number 8 Township Number T 19 S Range Number R 10 EW
 County: LYON

Distance and direction from nearest town or city street address of well if located within city?
NE CORN BLK 6 - PLYMOUTH APPROX 5M-W OF EMPORIA

2 WATER WELL OWNER: WARREN DRUMMOND ESTATE - MAURICE COPT
 RR#, St. Address, Box #: 1201 MAGIC CIRCLE Board of Agriculture, Division of Water Resources
 City, State, ZIP Code: EMPORIA KS 66801 Application Number:

3 LOCATE WELL'S LOCATION WITH AN "X" IN SECTION BOX:

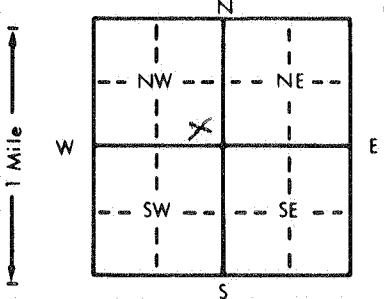

4 DEPTH OF COMPLETED WELL: 50 ft. ELEVATION: -
 Depth(s) Groundwater Encountered *1. UNKNOWN ft. 2. - ft. 3. - ft.

WELL'S STATIC WATER LEVEL: 24 ft. below land surface measured on mo/day/yr 07-13-92
 Pump test data: Well water was NOT TESTED after - hours pumping - gpt
 Est. Yield - gpm: Well water was - ft. after - hours pumping - gpt
 Bore Hole Diameter UNKNOWN in. to - ft., and - in. to - ft.

WELL WATER TO BE USED AS:
 1 Domestic SB 3 Feedlot 6 Oil field water supply 9 Dewatering 12 Other (Specify below)
 2 Irrigation 4 Industrial 7 Lawn and garden only 10 Monitoring well PLUGGED
 5 Public water supply 8 Air conditioning 11 Injection well

5 TYPE OF BLANK CASING USED:
 1 Steel 3 RMP (SR) 5 Wrought iron 8 Concrete tile CASING JOINTS: Glued - Clamped -
 2 PVC 4 ABS 6 Asbestos-Cement 9 Other (specify below) Welded -
 7 Fiberglass GALV. TIN - 5' SEC. SNAP CON. Threaded -
 Blank casing diameter S in. to TD ft., Dia - in. to - ft., Dia - in. to - ft.
 Casing height above land surface: 40 in., weight - lbs./ft. Wall thickness or gauge No. -

TYPE OF SCREEN OR PERFORATION MATERIAL: PROB. GALV. TIN. 7 PVC 10 Asbestos-cement
 1 Steel 3 Stainless steel 5 Fiberglass 8 RMP (SR) 11 Other (specify) -
 2 Brass 4 Galvanized steel 6 Concrete tile 9 ABS 12 None used (open hole)
 SCREEN OR PERFORATION OPENINGS ARE:
 1 Continuous slot 3 Mill slot 5 Gauzed wrapped 8 Saw cut 11 None (open hole)
 2 Louvered shutter 4 Key punched 6 Wire wrapped 9 Drilled holes
 7 Torch cut 10 Other (specify) UNKNOWN

SCREEN-PERFORATED INTERVALS: From UNKNOWN ft. to - ft., From - ft. to - ft.
 GRAVEL PACK INTERVALS: From 22 ft. to 50 ft., From - ft. to - ft.

6 GROUT MATERIAL: 1 Neat cement 2 Cement grout 3 Bentonite 4 Other -
 Grout Intervals: From GL ft. to 22 ft., From - ft. to - ft., From - ft. to - ft.
 What is the nearest source of possible contamination:
 1 Septic tank 4 Lateral lines 7 Pit privy 10 Livestock pens 14 Abandoned water well
 2 Sewer lines 5 Cess pool 8 Sewage lagoon 11 Fuel storage 15 Oil well/Gas well
 3 Watertight sewer lines 6 Seepage pit 9 Feedyard 12 Fertilizer storage 16 Other (specify below)
 13 Insecticide storage -
 Direction from well? - How many feet? -

FROM	TO	LITHOLOGIC LOG	FROM	TO	PLUGGING INTERVALS
		<u>NO RECORDS! GR. WATER</u>	<u>50</u>	<u>24</u>	<u>SAND</u>
		<u>PROB. 30 TO 35'</u>	<u>24</u>	<u>22</u>	<u>CLAY</u>
			<u>22</u>	<u>0</u>	<u>Bentonite clay</u>

7 CONTRACTOR'S OR LANDOWNER'S CERTIFICATION: This water well was (1) constructed, (2) reconstructed, or (3) plugged under my jurisdiction and was completed on (mo/day/year) 07-13-92 and this record is true to the best of my knowledge and belief. Kansas Water Well Contractor's License No. 479 This Water Well Record was completed on (mo/day/yr) 07-13-92 under the business name of EBBERTS DRILLING by (signature) Arogan McElbert

INSTRUCTIONS: Use typewriter or ball point pen. PLEASE PRESS FIRMLY and PRINT clearly. Please fill in blanks, underline or circle the correct answers. Send top three copies to Kansas Department of Health and Environment, Bureau of Water, Topeka, Kansas 66620-0001. Telephone: 913-296-5545. Send one to WATER WELL OWNER and retain one for your records.