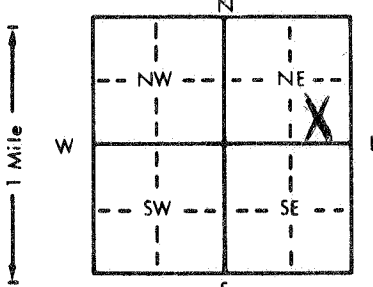


1 LOCATION OF WATER WELL: County: LYON Fraction: NE 1/4 SE 1/4 NE 1/4 Section Number: 9 Township Number: T 19 S Range Number: R 10 EW

2 WATER WELL OWNER: KENNETH L. OR LYNETTE D. STAIR
 RR#, St. Address, Box #: 384 RD. 175 Board of Agriculture, Division of Water Resource
 City, State, ZIP Code: EMPORIA KS. Application Number:

3 LOCATE WELL'S LOCATION WITH AN "X" IN SECTION BOX:


4 DEPTH OF COMPLETED WELL: 15' ft. ELEVATION:
 Depth(s) Groundwater Encountered: 1 DRY ft. 2. ft. 3. ft.
 WELL'S STATIC WATER LEVEL: 999' 0" NA ft. below land surface measured on mo/day/yr
 Pump test data: Well water was ft. after hours pumping gpm
 Est. Yield gpm: Well water was ft. after hours pumping gpm
 Bore Hole Diameter in. to ft., and in. to ft.
 WELL WATER TO BE USED AS: 5 Public water supply 8 Air conditioning 11 Injection well
 Domestic 3 Feedlot 6 Oil field water supply 9 Dewatering 12 Other (Specify below)
 2 Irrigation 4 Industrial 7 Lawn and garden only 10 Monitoring well
 Was a chemical/bacteriological sample submitted to Department? Yes No X; If yes, mo/day/yr sample was submitted
 Water Well Disinfected? Yes X No

5 TYPE OF BLANK CASING USED: 5 Wrought iron 8 Concrete tile CASING JOINTS: Glued Clamped
 1 Steel 3 RMP (SR) 6 Asbestos-Cement 9 Other (specify below) Welded
 2 PVC 4 ABS 7 Fiberglass ROCK Threaded
 Blank casing diameter: 4.0 in. to ft., Dia in. to ft., Dia in. to ft.
 Casing height above land surface: 480 in., weight lbs./ft. Wall thickness or gauge No.
 TYPE OF SCREEN OR PERFORATION MATERIAL: 7 PVC 10 Asbestos-cement
 1 Steel 3 Stainless steel 5 Fiberglass 8 RMP (SR) 11 Other (specify)
 2 Brass 4 Galvanized steel 6 Concrete tile 9 ABS None used (open hole)
 SCREEN OR PERFORATION OPENINGS ARE: 5 Gauzed wrapped 8 Saw cut None (open hole)
 1 Continuous slot 3 Mill slot 6 Wire wrapped 9 Drilled holes
 2 Louvered shutter 4 Key punched 7 Torch cut 10 Other (specify) NA
 SCREEN-PERFORATED INTERVALS: From NA ft. to NA ft., From ft. to ft.
 From ft. to ft., From ft. to ft.
 GRAVEL PACK INTERVALS: From ft. to ft., From ft. to ft.
 From ft. to ft., From ft. to ft.

6 GROUT MATERIAL: 1 Neat cement Cement grout 3 Bentonite 4 Other GRAVEL & CLAY MATH.
 Grout Intervals: From 1 ft. to 1 1/2 ft., From ft. to ft., From 1 1/2 ft. to 15 ft.
 What is the nearest source of possible contamination: 10 Livestock pens Abandoned water well
 1 Septic tank 4 Lateral lines 7 Pit privy 11 Fuel storage 15 Oil well/Gas well
 2 Sewer lines 5 Cess pool 8 Sewage lagoon 12 Fertilizer storage 16 Other (specify below)
 3 Watertight sewer lines 6 Seepage pit 9 Feedyard 13 Insecticide storage

Direction from well?		LITHOLOGIC LOG		PLUGGING INTERVALS	
FROM	TO	FROM	TO	FROM	TO
		0	1'		TOP SOIL
		1'	1 1/2'		CEMENT GROUT
		1 1/2'	15'		GRAVEL & CLAY MATH.

7 CONTRACTOR'S OR LANDOWNER'S CERTIFICATION: This water well was (1) constructed, (2) reconstructed, or plugged under my jurisdiction and was completed on (mo/day/year) 11/20/93 and this record is true to the best of my knowledge and belief. Kansas Water Well Contractor's License No. NONE This Water Well Record was completed on (mo/day/yr) 11-2-93 under the business name of NONE by (signature) Kenneth L. Stair

INSTRUCTIONS: Use typewriter or ball point pen. PLEASE PRESS FIRMLY and PRINT clearly. Please fill in blanks, underline or circle the correct answers. Send top three copies to Kansas Department of Health and Environment, Bureau of Water, Topeka, Kansas 66620-0001. Telephone: 913-296-5545. Send one to WATER WELL OWNER and retain one for your records.