

1 LOCATION OF WATER WELL: Fraction NE 1/4 SE 1/4 SE 1/4 Section Number 13 Township Number T 19 S Range Number R 10 E/W
 County: LYON

Distance and direction from nearest town or city street address of well if located within city?

1 M W 134 S FROM HWY 50 W

2 WATER WELL OWNER: DANA AND LINDA ANDERSON


RR#, St. Address, Box #: 3013 HACIENDA CT.

City, State, ZIP Code: EMPORIA KS 66801

Board of Agriculture, Division of Water Resources

Application Number:

3 LOCATE WELL'S LOCATION WITH AN "X" IN SECTION BOX:

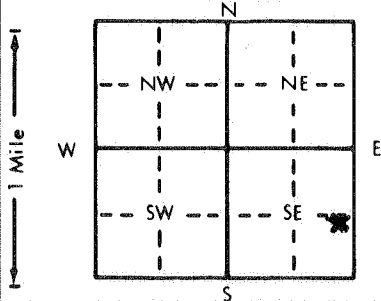

4 DEPTH OF COMPLETED WELL: 30 ft. ELEVATION:

Depth(s) Groundwater Encountered 1. UNKNOWN ft. 2. ft. 3. ft.

WELL'S STATIC WATER LEVEL 1.1 ft. below land surface measured on mo/day/yr 02-11-92

Pump test data: Well water was 22 ft. after 1/2 hours pumping 10 gpm

Est. Yield 1.0 gpm: Well water was ft. after hours pumping gpm

Bore Hole Diameter UNKNOWN ft., and in. to ft.

WELL WATER TO BE USED AS: 5 Public water supply 8 Air conditioning 11 Injection well

1 Domestic 3 Feedlot 6 Oil field water supply 9 Dewatering 12 Other (Specify below)

2 Irrigation 4 Industrial 7 Lawn and garden only 10 Monitoring well

Was a chemical/bacteriological sample submitted to Department? Yes No X; If yes, mo/day/yr sample was submitted

Water Well Disinfected? Yes No

5 TYPE OF BLANK CASING USED:

1 Steel 3 RMP (SR) 5 Wrought iron 8 Concrete tile CASING JOINTS: Glued Clamped

2 PVC 4 ABS 6 Asbestos-Cement 9 Other (specify below) GALV. Welded

Blank casing diameter 4 in. to 30 ft. Dia. in. to ft. Dia. in. to ft.

Casing height above land surface 24 in., weight SCH 40 lbs./ft. Wall thickness or gauge No.

TYPE OF SCREEN OR PERFORATION MATERIAL: 7 PVC 10 Asbestos-cement

1 Steel 3 Stainless steel 5 Fiberglass 8 RMP (SR) 11 Other (specify)

2 Brass 4 Galvanized steel 6 Concrete tile 9 ABS 12 None used (open hole)

SCREEN OR PERFORATION OPENINGS ARE: 5 Gauzed wrapped 8 Saw cut 11 None (open hole)

1 Continuous slot 3 Mill slot 6 Wire wrapped 9 Drilled holes

2 Louvered shutter 4 Key punched 7 Torch cut 10 Other (specify)

SCREEN-PERFORATED INTERVALS: From 25 ft. to 30 ft., From ft. to ft., From ft. to ft.

From ft. to ft., From ft. to ft.

GRAVEL PACK INTERVALS* From UNKNOWN ft. to ft., From ft. to ft., From ft. to ft.

From ft. to ft., From ft. to ft.

6 GROUT MATERIAL: 1 Neat cement 2 Cement grout 3 Bentonite 4 Other

Grout Intervals: From 1-6L ft. to 4 ft., From ft. to ft., From ft. to ft., From ft. to ft.

What is the nearest source of possible contamination: 10 Livestock pens 14 Abandoned water well


1 Septic tank 4 Lateral lines 7 Pit privy 11 Fuel storage 15 Oil well/Gas well

2 Sewer lines 5 Cess pool 8 Sewage lagoon 12 Fertilizer storage 16 Other (specify below)

3 Watertight sewer lines 6 Seepage pit 9 Feedyard 13 Insecticide storage

Direction from well? S - DOWN SLOPE How many feet? 50

FROM TO LITHOLOGIC LOG FROM TO PLUGGING INTERVALS

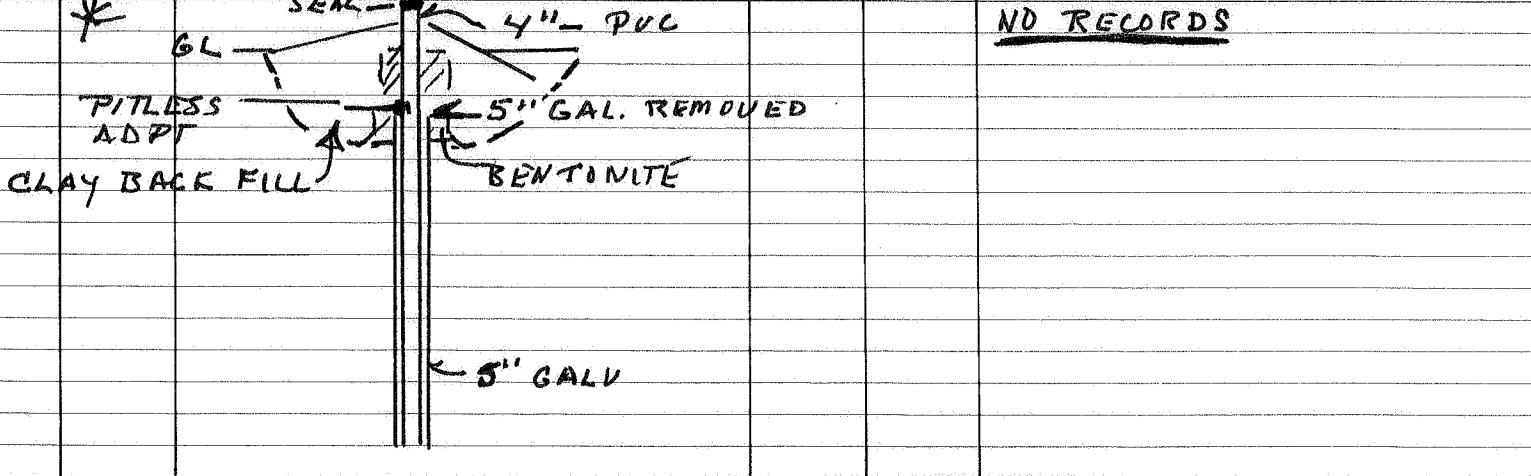

7 CONTRACTOR'S OR LANDOWNER'S CERTIFICATION: This water well was (1) constructed, (2) reconstructed, or (3) plugged under my jurisdiction and was completed on (mo/day/year) 02-21-92 and this record is true to the best of my knowledge and belief. Kansas

Water Well Contractor's License No. 479 This Water Well Record was completed on (mo/day/yr) 02-26-92

under the business name of EBBERTS DRILLING by (signature) Gregory Ebberts