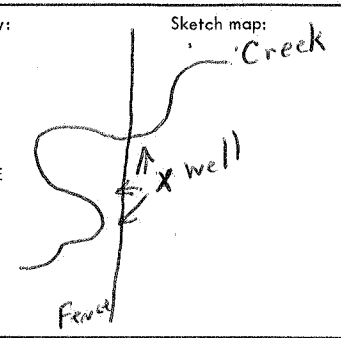


USE TYPEWRITER OR BALL POINT PEN-PRESS FIRMLY, PRINT CLEARLY.

WATER WELL RECORD
KSA 82a-1201-1215

Kansas Department of Health and Environment-Division of Environment (Water well Contractors) Topeka, Kansas 66620

1. Location of well:		County Lyon	Fraction SW 1/4 NE 1/4 SW 1/4	Section number 31	Township number T 19 S R 10 E	Range number 10 E
2. Distance and direction from nearest town or city: 2 mile East and 3 1/2 South of SAFFORDVILLE			3. Owner of well: STEVE Swigent R.R. or street: Rt 5 City, state, zip code: Emporia			
4. Locate with "X" in section below:			Sketch map: 		6. Bore hole dia. 10 in. Completion date 2-14-77 Well depth 50 ft.	
5. Type and color of material			From	To	7. <input checked="" type="checkbox"/> Cable tool <input type="checkbox"/> Rotary <input type="checkbox"/> Driven <input type="checkbox"/> Dug <input type="checkbox"/> Hollow rod <input type="checkbox"/> Jetted <input type="checkbox"/> Bored <input type="checkbox"/> Reverse rotary	
Topsail			0	2	8. Use: <input checked="" type="checkbox"/> Domestic <input type="checkbox"/> Public supply <input type="checkbox"/> Industry <input type="checkbox"/> Irrigation <input type="checkbox"/> Air conditioning <input type="checkbox"/> Stock <input type="checkbox"/> Lawn <input type="checkbox"/> Oil field water <input type="checkbox"/> Other	
Clay - Brw			2	18	9. Casing: Material PILS Height Above or below Threaded <input type="checkbox"/> Welded glw Surface 4 1/2 in. RMP PVC Weight _____ lbs./ft. Dia. 5 in. to 23 ft. depth Wall Thickness: inches or Dia. _____ in. to _____ ft. depth gage No. 1200	
Gravel-Chert - and Clay - Brw			18	24	10. Screen: Manufacturer's name Sunflower Type RMP Dia. 5" Slot/gauze YA Length 27' Set between 23 ft. and 50 ft. Gravel pack? Yes Size range of material 4-1"	
LIME - Buff (TAN)			24	28	11. Static water level: _____ mo./day/yr. 23 ft. below land surface Date 2-14-77	
Shale - Green			28	31	12. Pumping level below land surfaces: _____ ft. after _____ hrs. pumping _____ g.p.m. _____ ft. after _____ hrs. pumping _____ g.p.m. Estimated maximum yield 5 g.p.m.	
LIME - Buff			31	34	13. Water sample submitted: _____ mo./day/yr. <input type="checkbox"/> Yes <input checked="" type="checkbox"/> No Date _____	
Shale - Blue			34	38	14. Well head completion: <input type="checkbox"/> Pitless adapter 4 1/2 Inches above grade	
LIME Buff			38	40	15. Well grouted? Yes With: <input type="checkbox"/> Neat cement <input type="checkbox"/> Bentonite <input checked="" type="checkbox"/> Concrete Depth: From 3 ft. to 13 ft.	
Shale - Blue			40	44	16. Nearest source of possible contamination: ft. 150 Direction NW Type Creek Well disinfected upon completion? <input checked="" type="checkbox"/> Yes <input type="checkbox"/> No	
Flint or LIME - Gray			44	47	17. Pump: <input checked="" type="checkbox"/> Not installed Manufacturer's name _____ Model number _____ HP _____ Volts _____ Length of drop pipe _____ ft. capacity _____ g.p.m. Type: <input type="checkbox"/> Submersible <input type="checkbox"/> Turbine <input type="checkbox"/> Jet <input type="checkbox"/> Reciprocating <input type="checkbox"/> Centrifugal <input type="checkbox"/> Other	
Shale - Dark			47	50	20. Water well contractor's certification: This well was drilled under my jurisdiction and this report is true to the best of my knowledge and belief. Zinn Water Well Drilling 218 Business name _____ License No. _____ Address Lost Springs, Kan Signed Joseph A. Zinn Date 2-20-77 Authorized representative	
18. Elevation:			19. Remarks: The 4'x4'x4" thick reinforced concrete slab to be installed by customer - he knows this is a regulation & Steven Swigent		20. Water well contractor's certification:	
Topography: <input type="checkbox"/> Hill <input checked="" type="checkbox"/> Slope <input type="checkbox"/> Upland <input type="checkbox"/> Valley			(Use a second sheet if needed)			

Forward the white, blue and pink copies to the Department of Health and Environment

Form WWC-5

19 10 E 31 SW 1/4