

1 LOCATION OF WATER WELL:	Fraction	Section Number	Township Number	Range Number
County: Lyon	SE ¼ NE ¼ NE ¼	13	19	10 E

Distance and direction from nearest town or city street address of well if located within city?
¼ mile south of 6th Street & 100' west of G. Road

2 WATER WELL OWNER:	BNSF		
RR#, St. Address, Box #	4200 Deen Road		
City, State, ZIP Code :	Fort Worth TX 76137		
	Board of Agriculture, Division of Water Resources Application Number:		

3 MARK WELL'S LOCATION WITH AN "X" IN SECTION BOX:

4 DEPTH OF WELL **27** ft.

WELL'S STATIC WATER LEVEL **NA** ft.


WELL WAS USED AS:

- | | | |
|--------------|------------------------------|-------------------------------------|
| 1 Domestic | 5 Public Water Supply | 9 Dewatering |
| 2 Irrigation | 6 Oil Field Water Supply | 10 Monitoring Well |
| 3 Feedlot | 7 Lawn and Garden (domestic) | 11 Injection Well |
| 4 Industrial | 8 Air Conditioning | 12 Other <u>Water Supply</u> |

Was a chemical/bacteriological sample submitted to Department? Yes ___ No **X**

If yes, mo/day/yr sample was submitted _____

Water Well Disinfected: Yes ___ No **X**

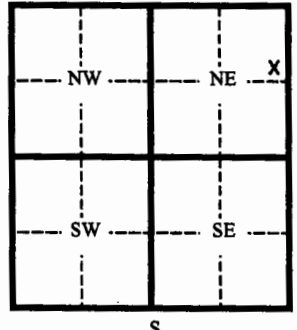

5 TYPE OF BLANK CASING USED:			
1 Steel	3 RMP (SR)	5 Wrought	7 Fiberglass
2 PVC	4 ABC	6 Asbestos-Cement	8 Concrete Tile
Blank casing diameter 6.5 in. Was casing pulled? Yes X No ___ If yes, how much 27 foot			
Casing height above or below land surface 0.0 in. See below for additional information on casing			

6 GROUT PLUG MATERIAL: 1 Neat cement 2 Cement grout 3 Bentonite 4 Other _____			
Grout Plug Intervals From 0 ft. to 27 ft. From _____ ft. to _____ ft. From _____ ft. to _____ ft.			

What is the nearest source of possible contamination:

- | | | | |
|--------------------------|-------------------|-------------------------|--------------------------|
| 1 Septic tank | 6 Seepage pit | 11 Fuel storage | 16 Other (specify below) |
| 2 Sewer lines | 7 Pit privy | 12 Fertilizer storage | |
| 3 Watertight sewer lines | 8 Sewage lagoon | 13 Insecticide storage | |
| 4 Lateral lines | 9 Feedyard | 14 Abandoned water well | |
| 5 Cess Pool | 10 Livestock pens | 15 Oil well/ Gas well | |

Direction from well? _____ How many feet? _____

FROM	TO	CODE	PLUGGING MATERIALS
0	27		Bentonite Chips ~750 lbs
			Encountered a sheen of unknown product
			while plugging the well.

Outer casing consisted of 9.5-inch Steel casing which extended ~20 ft. in depth. All the outer casing was pulled.

7	CONTRACTOR'S OR LANDOWNER'S CERTIFICATION: This water well was plugged under my jurisdiction and was completed on (mo/day/yr) 4-27-06 and this record is true to the best of my knowledge and belief. Kansas Water Well Contractor's License No. 531 This Water Well Record was completed on (mo/day/yr) 4-27-06 under the business name of Geotechnical Services, Inc. by (signature) <i>Allison M. [Signature]</i>
---	--

INSTRUCTIONS: Please fill in blanks and circle the correct answers. Send three copies to Kansas Department of Health and Environment, Bureau of Water, 1000 S W Jackson St., Ste. 420, Topeka, Kansas 66620-0001. Telephone: 785-296-3565. Send one to Water Well Owner and retain one for your records.