


1 LOCATION OF WATER WELL: County: LYON Fraction: NW 1/4 NW 1/4 NW 1/4 Section Number: 26 Township Number: T 19 S Range Number: R 10 EW

Distance and direction from nearest town or city street address of well if located within city?
1 S - 2 W - EMPORIA

2 WATER WELL OWNER: GIBSON'S RECYCLING
 RR#, St. Address, Box #: 539 ROAD 150 Board of Agriculture, Division of Water Resources
 City, State, ZIP Code: EMPORIA KS 66801 Application Number:

3 LOCATE WELL'S LOCATION WITH AN "X" IN SECTION BOX:

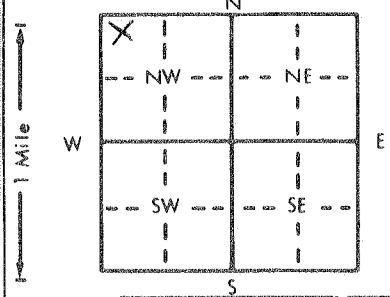

4 DEPTH OF COMPLETED WELL: 35 ft. ELEVATION:
 Depth(s) Groundwater Encountered 1. 30 ft. 2. ft. 3. ft.
 WELL'S STATIC WATER LEVEL: 18 ft. below land surface measured on mo/day/yr 07-03-97
 Pump test data: Well water was ft. after 2 hours pumping 1.5 gpm
 Est. Yield 8 gpm: Well water was ft. after hours pumping gpm
 Bore Hole Diameter: 12 in. to 3.5 ft., and in. to ft.
 WELL WATER TO BE USED AS: 5 Public water supply 8 Air conditioning 11 Injection well
 1 Domestic 3 Feedlot 6 Oil field water supply 9 Dewatering 12 Other (Specify below)
 2 Irrigation 4 Industrial 7 Lawn and garden only 10 Monitoring well
 Was a chemical/bacteriological sample submitted to Department? Yes No X; If yes, mo/day/yr sample was submitted
 Water Well Disinfected? Yes X No

5 TYPE OF BLANK CASING USED: 5 Wrought iron 8 Concrete tile CASING JOINTS: Glued X Clamped
 1 Steel 3 RMP (SR) 6 Asbestos-Cement 9 Other (specify below) Welded
 2 PVC 4 ABS 7 Fiberglass Threaded
 Blank casing diameter 5 in. to 2.5 ft., Dia. in. to ft., Dia. in. to ft.
 Casing height above land surface: 24 in., weight SCH 40 lbs./ft. Wall thickness or gauge No.

TYPE OF SCREEN OR PERFORATION MATERIAL: 7 PVC 10 Asbestos-cement
 1 Steel 3 Stainless steel 5 Fiberglass 8 RMP (SR) 11 Other (specify)
 2 Brass 4 Galvanized steel 6 Concrete tile 9 ABS 12 None used (open hole)

SCREEN OR PERFORATION OPENINGS ARE: 5 Gauzed wrapped 8 Saw cut 11 None (open hole)
 1 Continuous slot 3 Mill slot 6 Wire wrapped 9 Drilled holes
 2 Louvered shutter 4 Key punched 7 Torch cut 10 Other (specify)

SCREEN-PERFORATED INTERVALS: From 2.5 ft. to 3.5 ft., From ft. to ft.
 From ft. to ft., From ft. to ft.
 GRAVEL PACK INTERVALS: From 2.0 ft. to 3.5 ft., From ft. to ft.
 From ft. to ft., From ft. to ft.

6 GROUT MATERIAL: 1 Neat cement 2 Cement grout 3 Bentonite 4 Other
 Grout Intervals: From 5 ft. to 2.0 ft., From ft. to ft., From ft. to ft.
 What is the nearest source of possible contamination:
 1 Septic tank 4 Lateral lines 7 Pit privy 10 Livestock pens 14 Abandoned water well
 2 Sewer lines 5 Cess pool 8 Sewage lagoon 11 Fuel storage 15 Oil well/Gas well
 3 Watertight sewer lines 6 Seepage pit 9 Feedyard 12 Fertilizer storage 16 Other (specify below)
 13 Insecticide storage SALVAGE YARD
 Direction from well? SW How many feet? 25

FROM	TO	LITHOLOGIC LOG	FROM	TO	PLUGGING INTERVALS
<u>0</u>	<u>6</u>	<u>TOP SOIL</u>			
<u>6</u>	<u>18</u>	<u>SILT - DK GREY - BROWN</u>			
<u>18</u>	<u>30</u>	<u>CLAY SILT</u>			
<u>30</u>	<u>34</u>	<u>GRAVEL</u>			
<u>34</u>	<u>35</u>	<u>SHALE</u>			

7 CONTRACTOR'S OR LANDOWNER'S CERTIFICATION: This water well was (1) constructed, (2) reconstructed, or (3) plugged under my jurisdiction and was completed on (mo/day/year) 07-03-97 and this record is true to the best of my knowledge and belief. Kansas Water Well Contractor's License No. 479 This Water Well Record was completed on (mo/day/yr) 07-24-97 under the business name of EBBERTS DRILLING by (signature) [Signature]