

WATER WELL RECORD


Form WWC-5

Division of Water Resources App. No. []

1 LOCATION OF WATER WELL: County: LYON Fraction NW 1/4 NE 1/4 NE 1/4 NE 1/4 Section Number 3 Township No. T 19 S Range Number R 10 E

Street/Rural Address of Well Location; if unknown, distance & direction from nearest town or intersection: If at owner's address, check here [X]. Global Positioning System (GPS) information: Latitude: 38.433527 Longitude: -94.284393

2 WATER WELL OWNER: CORY & RICHELLE SMITH RR#, Street Address, Box #: 483 ROAD 190 City, State, ZIP Code : EMPORIA, KS 66801

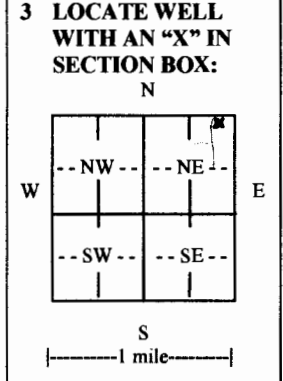

3 LOCATE WELL WITH AN 'X' IN SECTION BOX: 4 DEPTH OF COMPLETED WELL 200 ft. 4-200' BORES Depth(s) Groundwater Encountered (1) 0 ft. (2) ft. (3) ft. WELL'S STATIC WATER LEVEL 0 ft. below land surface measured on mo/day/yr...

5 TYPE OF CASING USED: Steel PVC Other H.D. POLYETHYLENE CASING JOINTS: Glued Clamped Welded Threaded FUSION Casing diameter 3/4 in. to 200 ft., Diameter in. to ft., Diameter in. to ft. Casing height above land surface 36 in., Weight SDR11 lbs./ft., Wall thickness or gauge No. 160 PSI

TYPE OF SCREEN OR PERFORATION MATERIAL: NONE Steel Stainless Steel PVC Other (Specify) Brass Galvanized Steel None used (open hole) SCREEN OR PERFORATION OPENINGS ARE: NONE Continuous slot Mill slot Gauze wrapped Torch cut Drilled holes None (open hole) Louvered shutter Key punched Wire wrapped Saw cut Other (specify) SCREEN-PERFORATED INTERVALS: From ft. to ft., From ft. to ft., From ft. to ft. GRAVEL PACK INTERVALS: From ft. to ft., From ft. to ft., From ft. to ft.

6 GROUT MATERIAL: Neat cement Cement grout Bentonite Other Grout Intervals: From 200 ft. to 3 ft., From ft. to ft., From ft. to ft. What is the nearest source of possible contamination: Septic tank Lateral lines Pit privy Livestock pens Insecticide storage Other (specify below) Sewer lines Cesspool Sewage lagoon Fuel storage Abandoned water well Watertight sewer lines Seepage pit Feedyard Fertilizer storage Oil well/gas well Direction from well Distance from well

Table with columns: FROM, TO, LITHOLOGIC LOG, FROM, TO, LITHO. LOG (cont.) or PLUGGING INTERVALS. Rows include SOIL/CLAY, SANDSTONE, LIME, SHALE, and 4-200' BORES PLUGGED WITH HIGH SOLID BENTONITE.

7 CONTRACTOR'S OR LANDOWNER'S CERTIFICATION: This water well was constructed, reconstructed, or plugged under my jurisdiction and was completed on (mo/day/year) 7/16/2015 and this record is true to the best of my knowledge and belief. Kansas Water Well Contractor's License No. 561 This Water Well Record was completed on (mo/day/year) 7/17/2015 under the business name of EVANS ENERGY DEVELOPMENT, INC. by (signature) []

INSTRUCTIONS: Use typewriter or ball point pen. PLEASE PRESS FIRMLY and PRINT clearly. Please fill in blanks and check the correct answers. Send one copy to Kansas Department of Health and Environment, Bureau of Water, Geology Section, 1000 SW Jackson St., Suite 420, Topeka, Kansas 66612-1367. Telephone 785-296-5524. Send one copy to WATER WELL OWNER and retain one for your records. Include fee of \$5.00 for each constructed well. Visit us at